



Thurston County Auditor's Office

2022 Precinct Maintenance Plan




Overview

- Thurston County currently has 285 voting precincts.
- In accordance with RCW 29A.16.040:
 - No changes may be made during the period starting fourteen days prior to the first day for candidates to file for the Primary Election.
 - No precinct may exceed 1,500 active registered voters.
- In accordance with RCW 29A.16.050:
 - Every voting precinct must be wholly within a single congressional district, a single legislative district, a single district of a county legislative authority, and, if applicable, a single city.
 - Every voting precinct must be composed, as nearly as practicable, of contiguous and compact areas.
- There are no changes to County Commissioner District boundaries that were approved in 2021.

Overview of Changes Submitted to the Legislature

Yellow line = Legislative District (LD) line from the Redistricting Commission (RC)


Purple line = Legislative District (LD) line approved by the WA State Legislature per our suggested changes

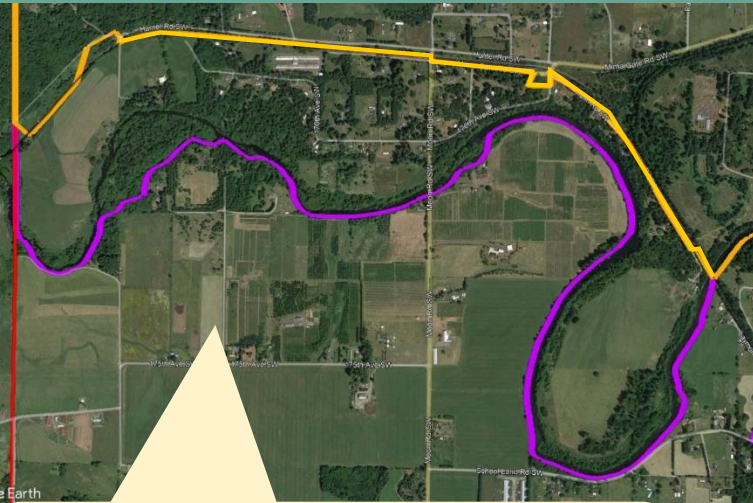


Change: Follow the RC congressional district line (also the purple line).




Change: Follow Hwy 12 for a cleaner boundary.

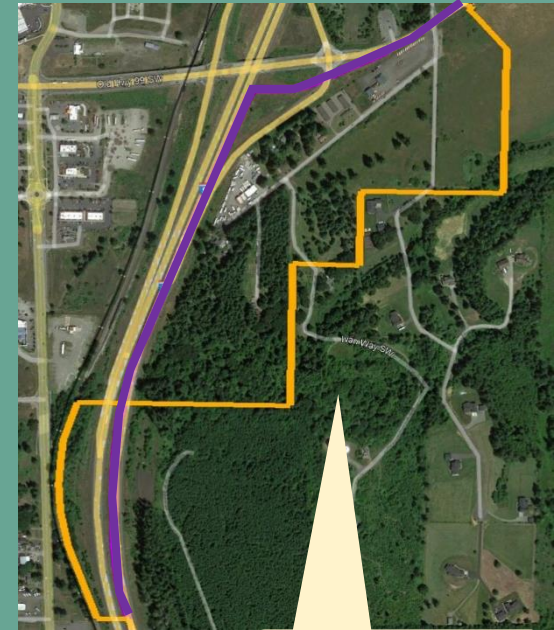

Change: Follow roads instead of census blocks.

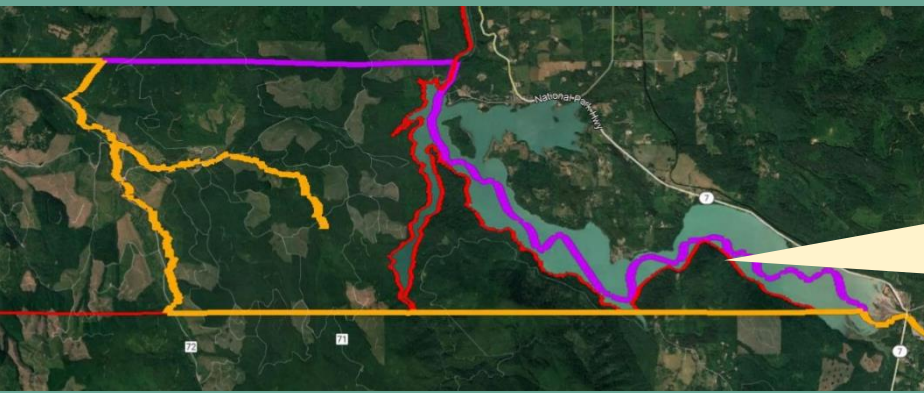


Change: Continue to follow section lines, not the Deschutes River.

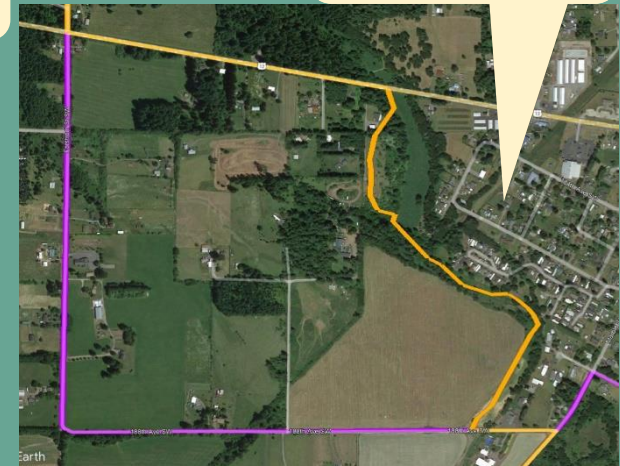


Congressional Districts (CD)

**Before 2020 Census
Redistricting**

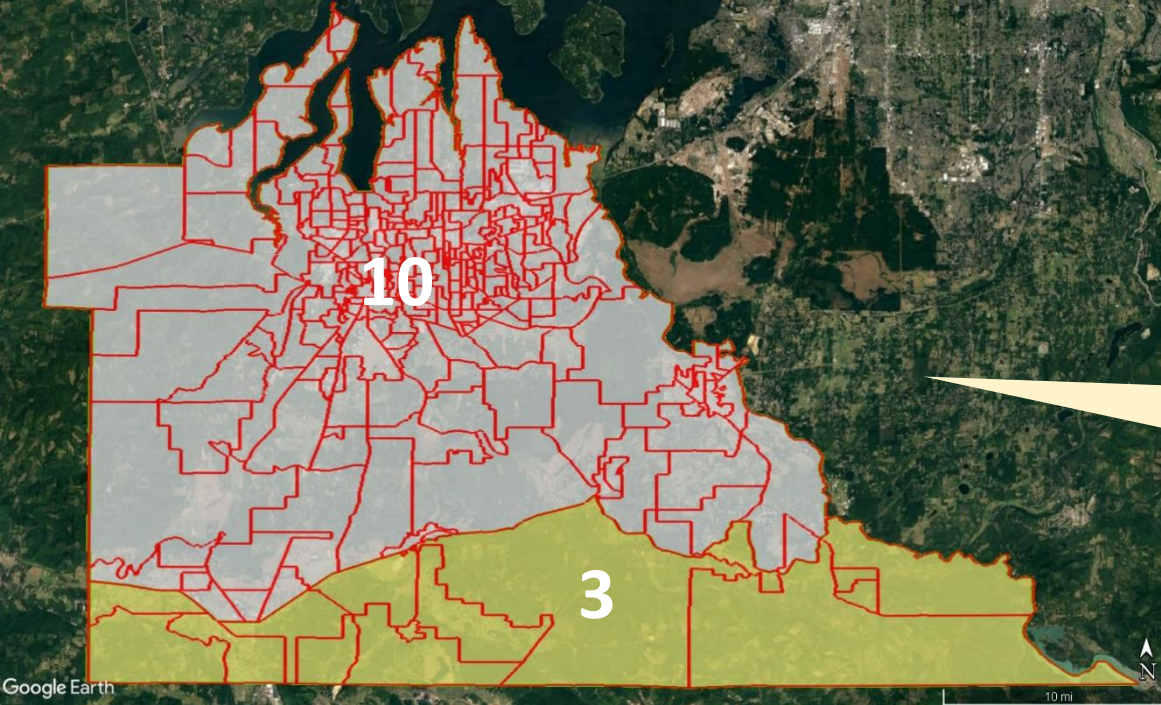


**After 2020 Census
Redistricting**

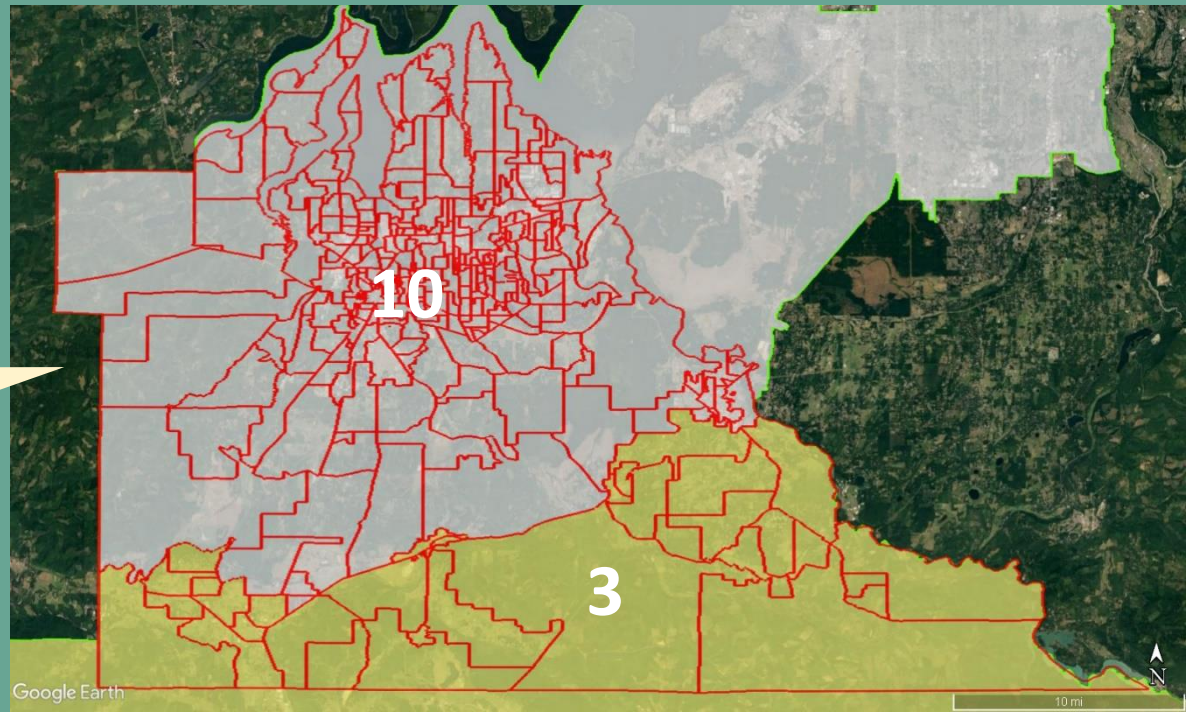



Legislative Districts (LD)

Before 2020 Census
Redistricting

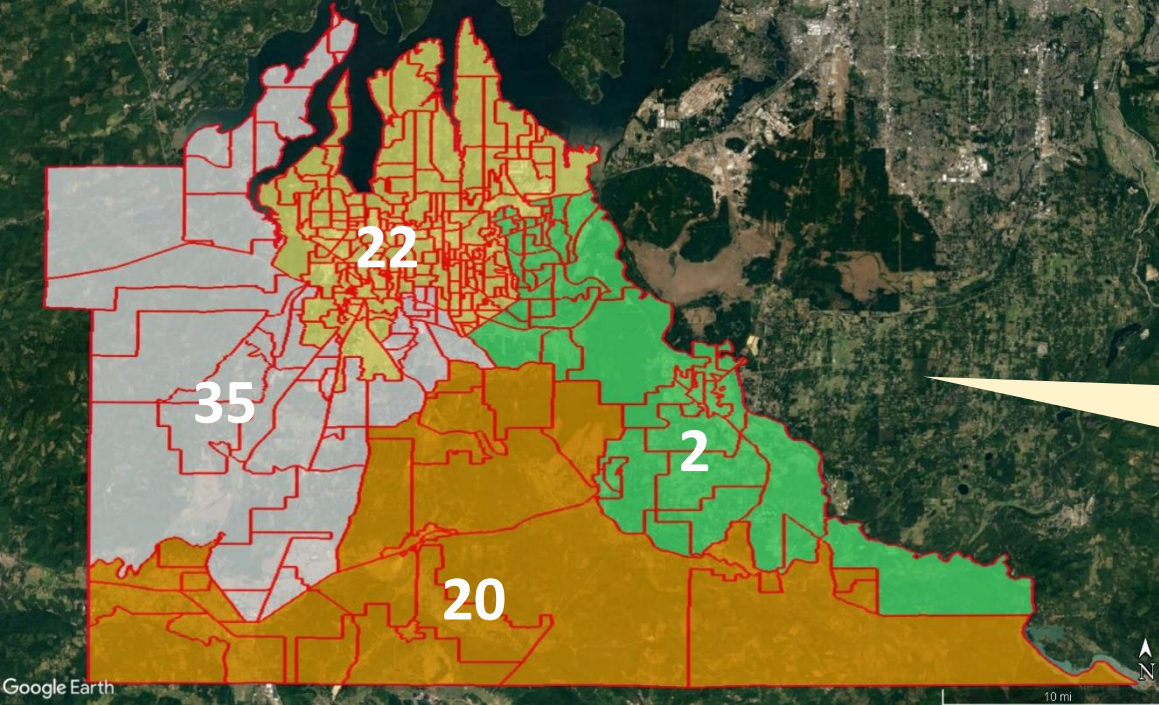


After 2020 Census
Redistricting

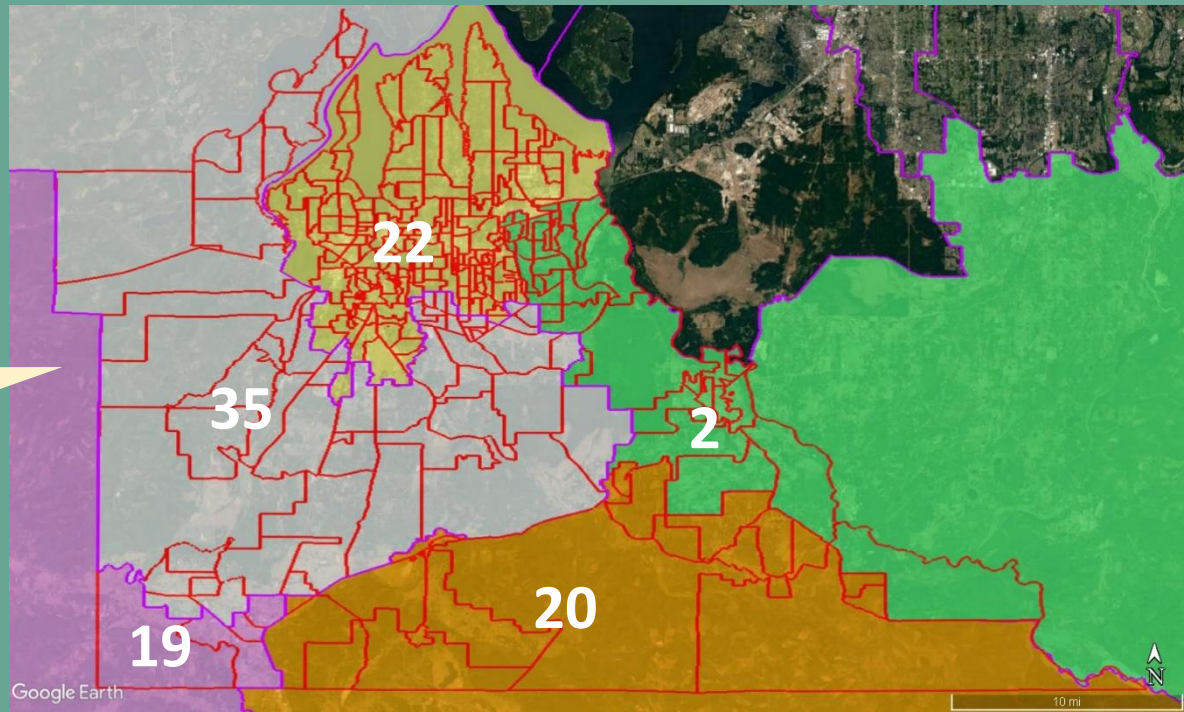

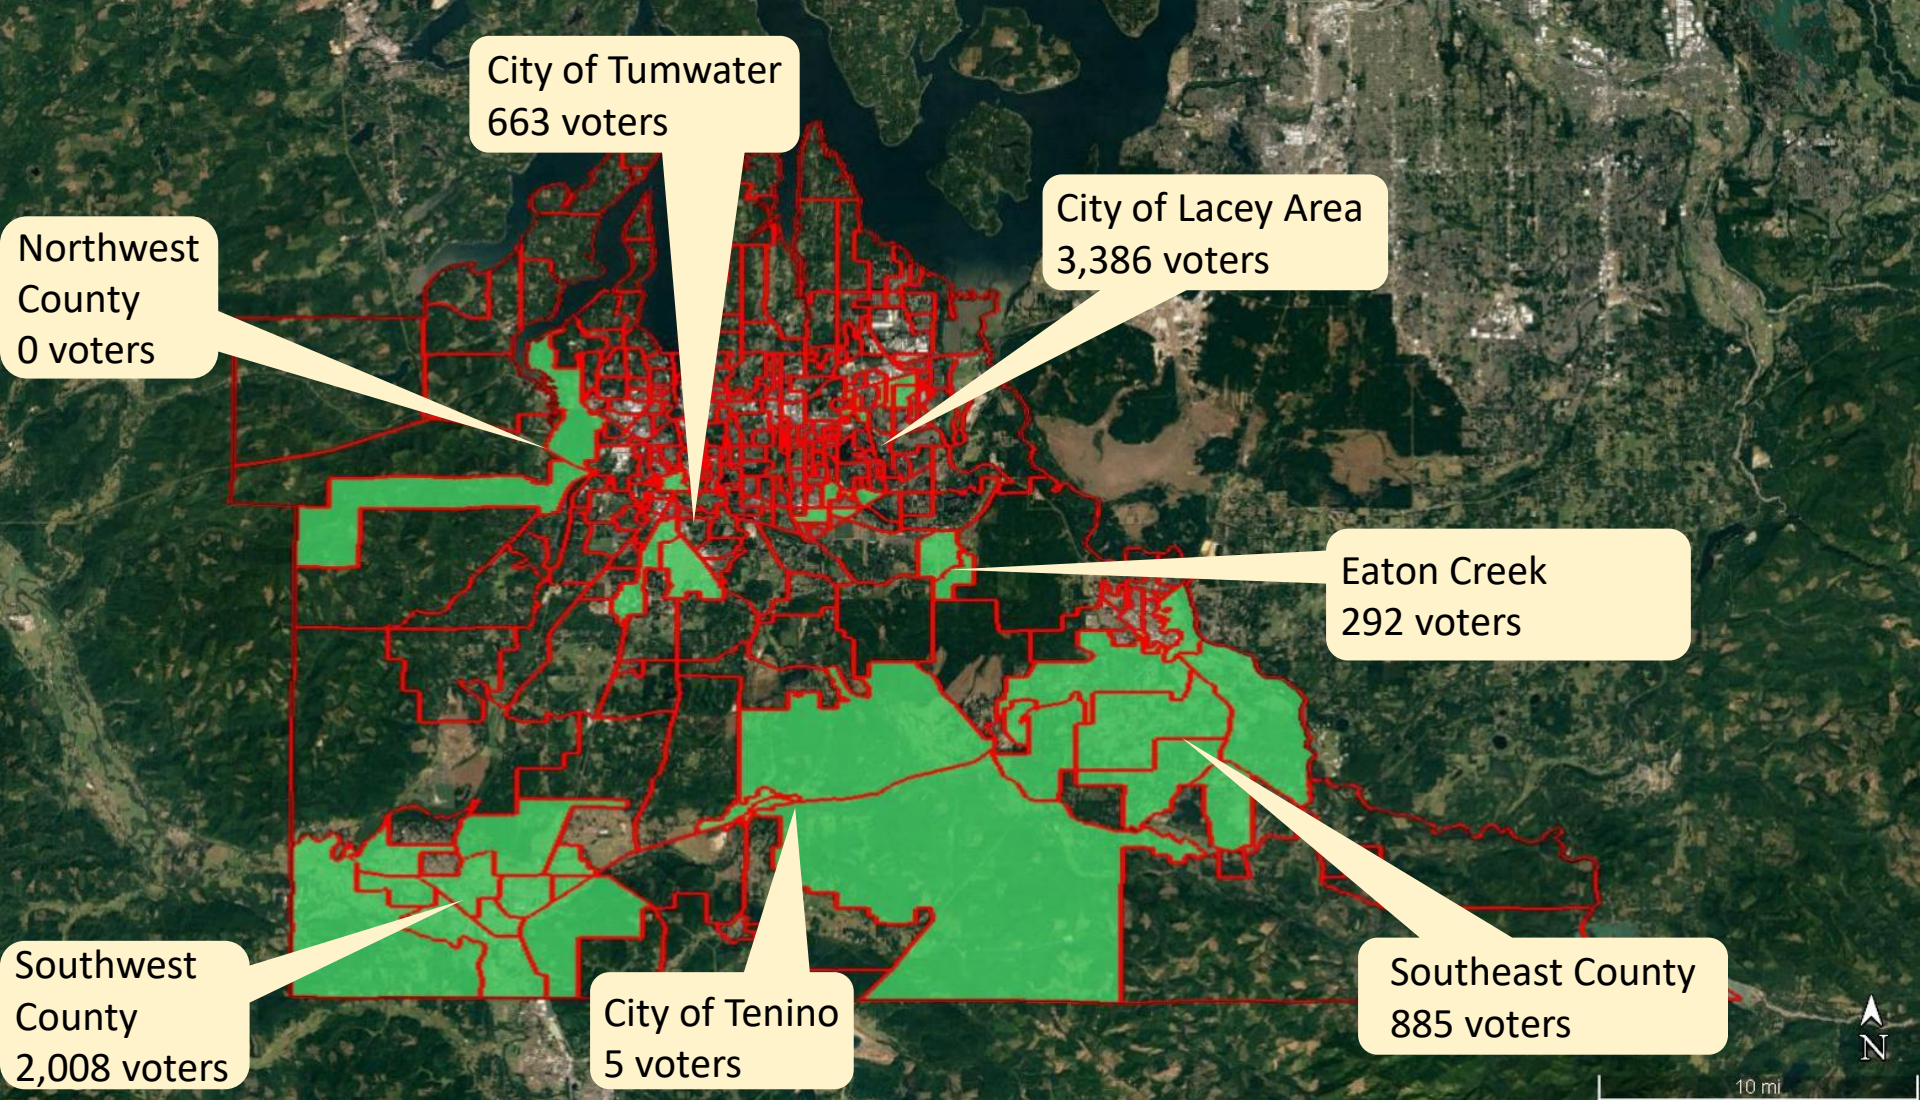

Overview


- 7 areas of adjustments due to City of Lacey Annexations, New Congressional District (CD) and/or Legislative District (LD) lines, and a precinct over 1,500 active registered voters
- Approx. voters affected = 7,239

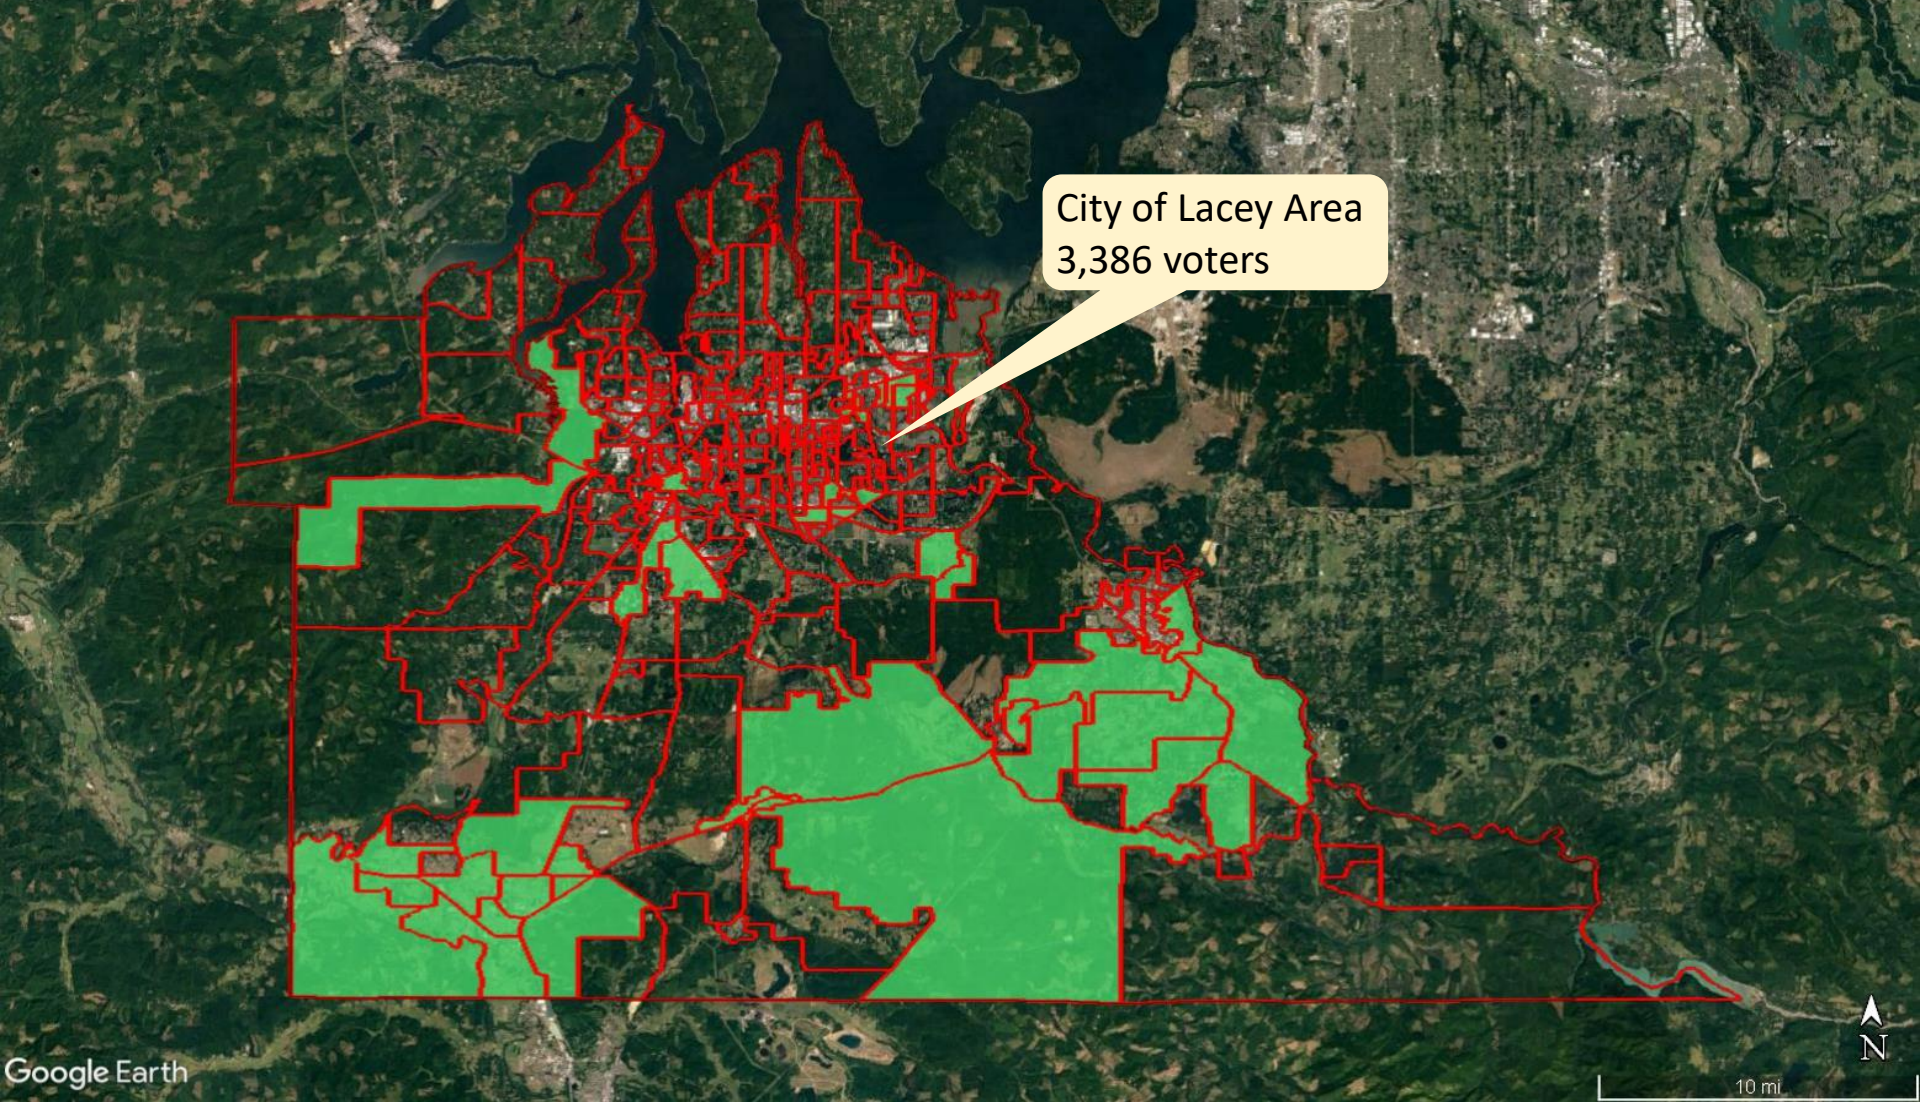

City of Lacey Annexations and Adjustments

- 3 City of Lacey Annexations:
 - Steilacoom/Marvin Rd, Capitol City/Chambers Estates, and Mosure
- Adjustments due to new legislative district lines


Purple line = LD
Green line = CD
Red line = Precinct line
Orange line = Annexation area/proposed move

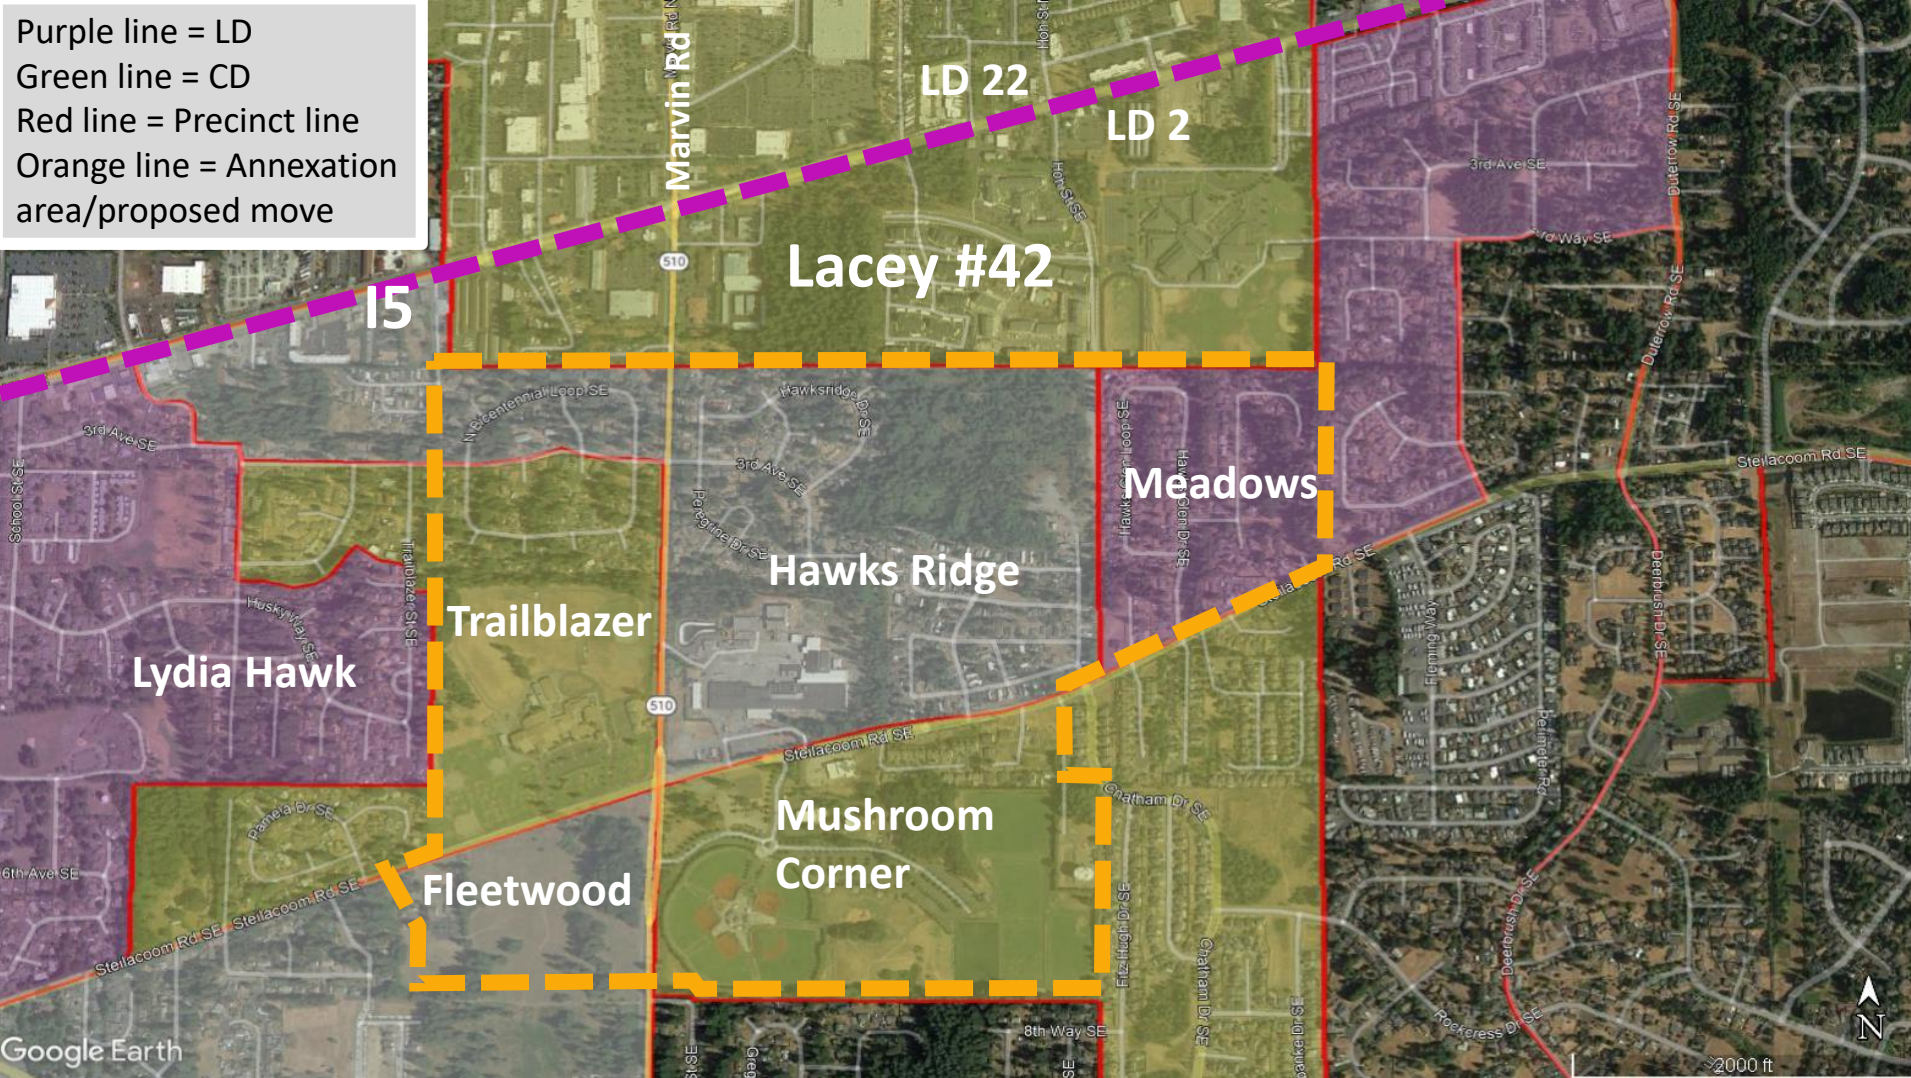

City of Lacey Annexation – Steilacoom/Marvin Rd

- Approx. voter totals of Mushroom Corner (Pct. 92) = 1,132, Trailblazer (Pct. 93) = 355, Fleetwood (Pct. 118) = 1,050, Hawks Ridge (Pct. 167) = 485, Meadows (Pct. 196) = 902, Lacey #42 (Pct. 342) = 867, Lydia Hawk (Pct. 119) = 1,311
- Approx. voters annexed = 648
- Approx. voters affected = 1,439


Purple line = LD
 Green line = CD
 Red line = Precinct line
 Orange line = Annexation
 area/proposed move

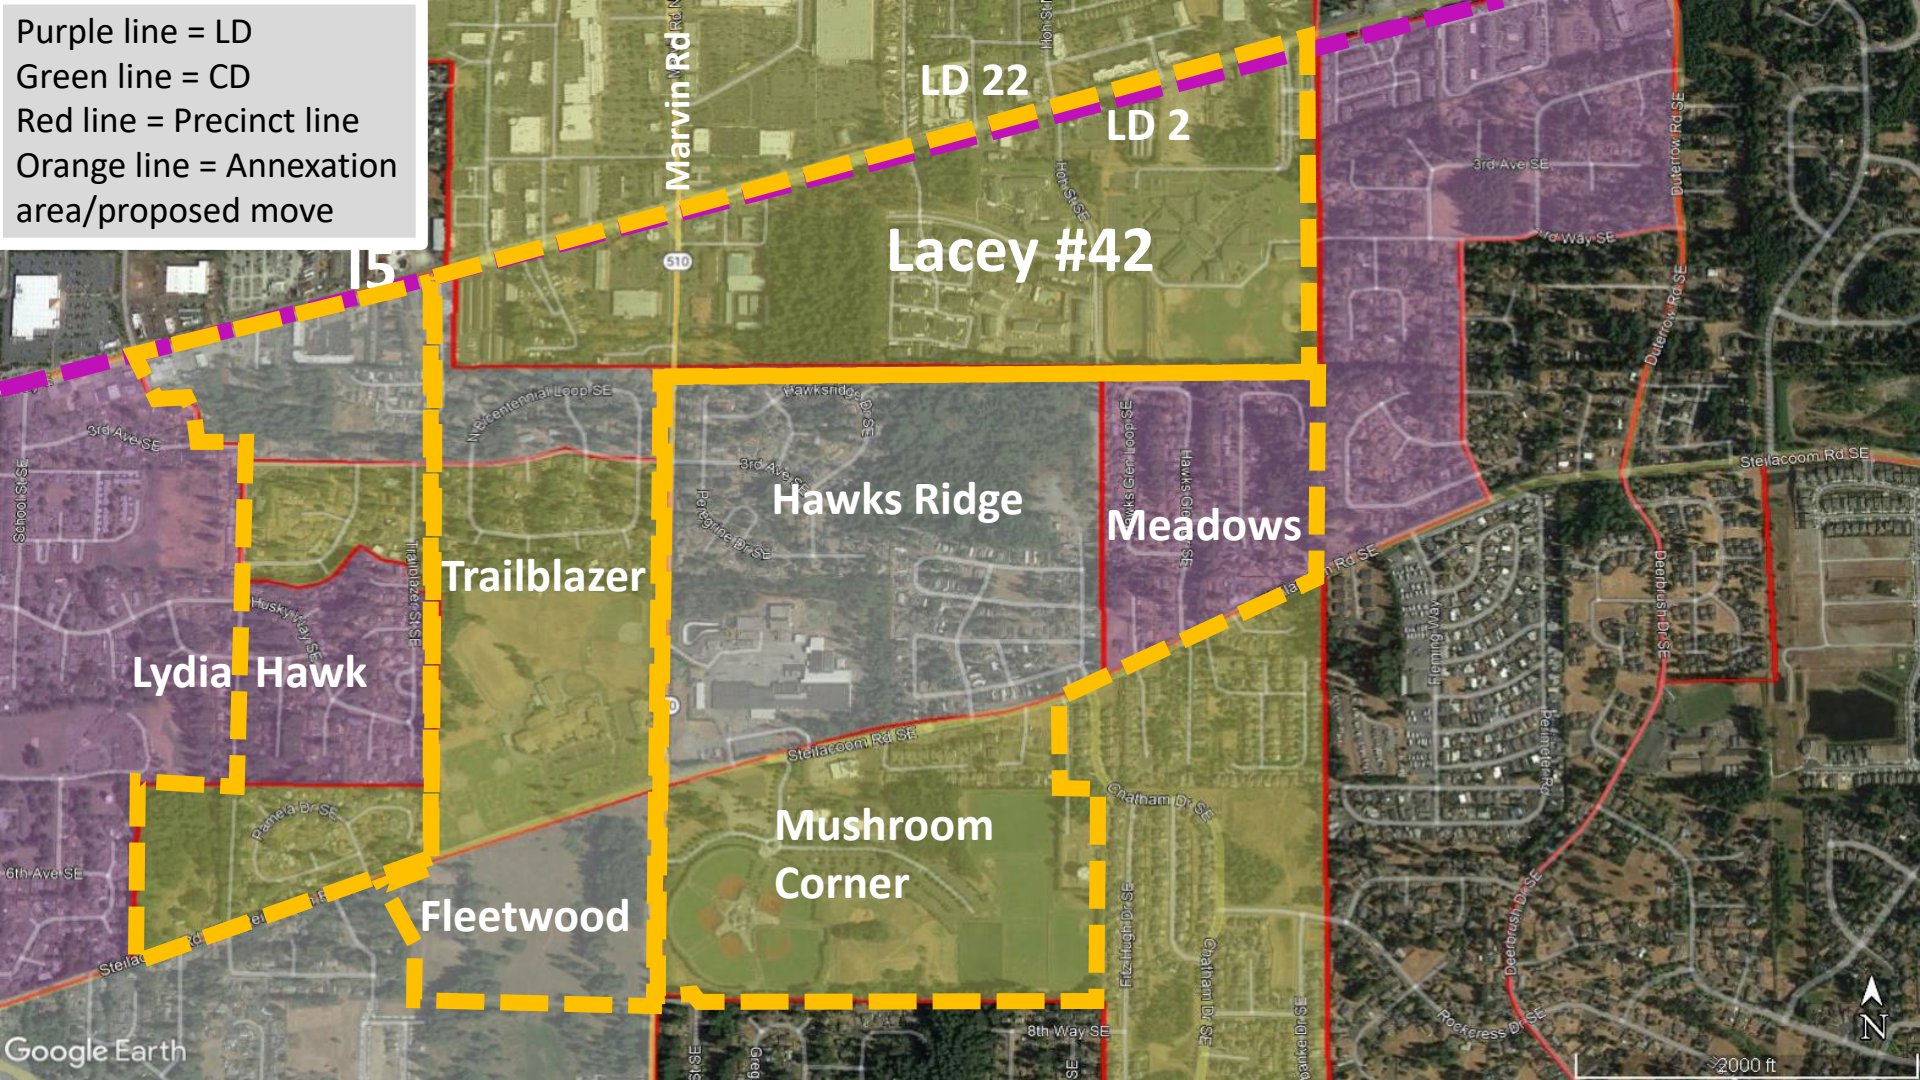

City of Lacey Annexation – Steilacoom/Marvin Rd

- Combine annexed area east of Marvin Rd and create new Lacey #56 (Pct. 356)
- Combine annexed area west of Marvin Rd with Lacey #42 in LD 2 and create new Lacey #58 (Pct. 358)
- Reform unincorporated Trailblazer with unincorporated Hawks Ridge (retiring Hawks Ridge) with part of Lydia Hawk to form new boundaries for Trailblazer and Lydia Hawk

Purple line = LD
 Green line = CD
 Red line = Precinct line
 Orange line = Annexation
 area/proposed move

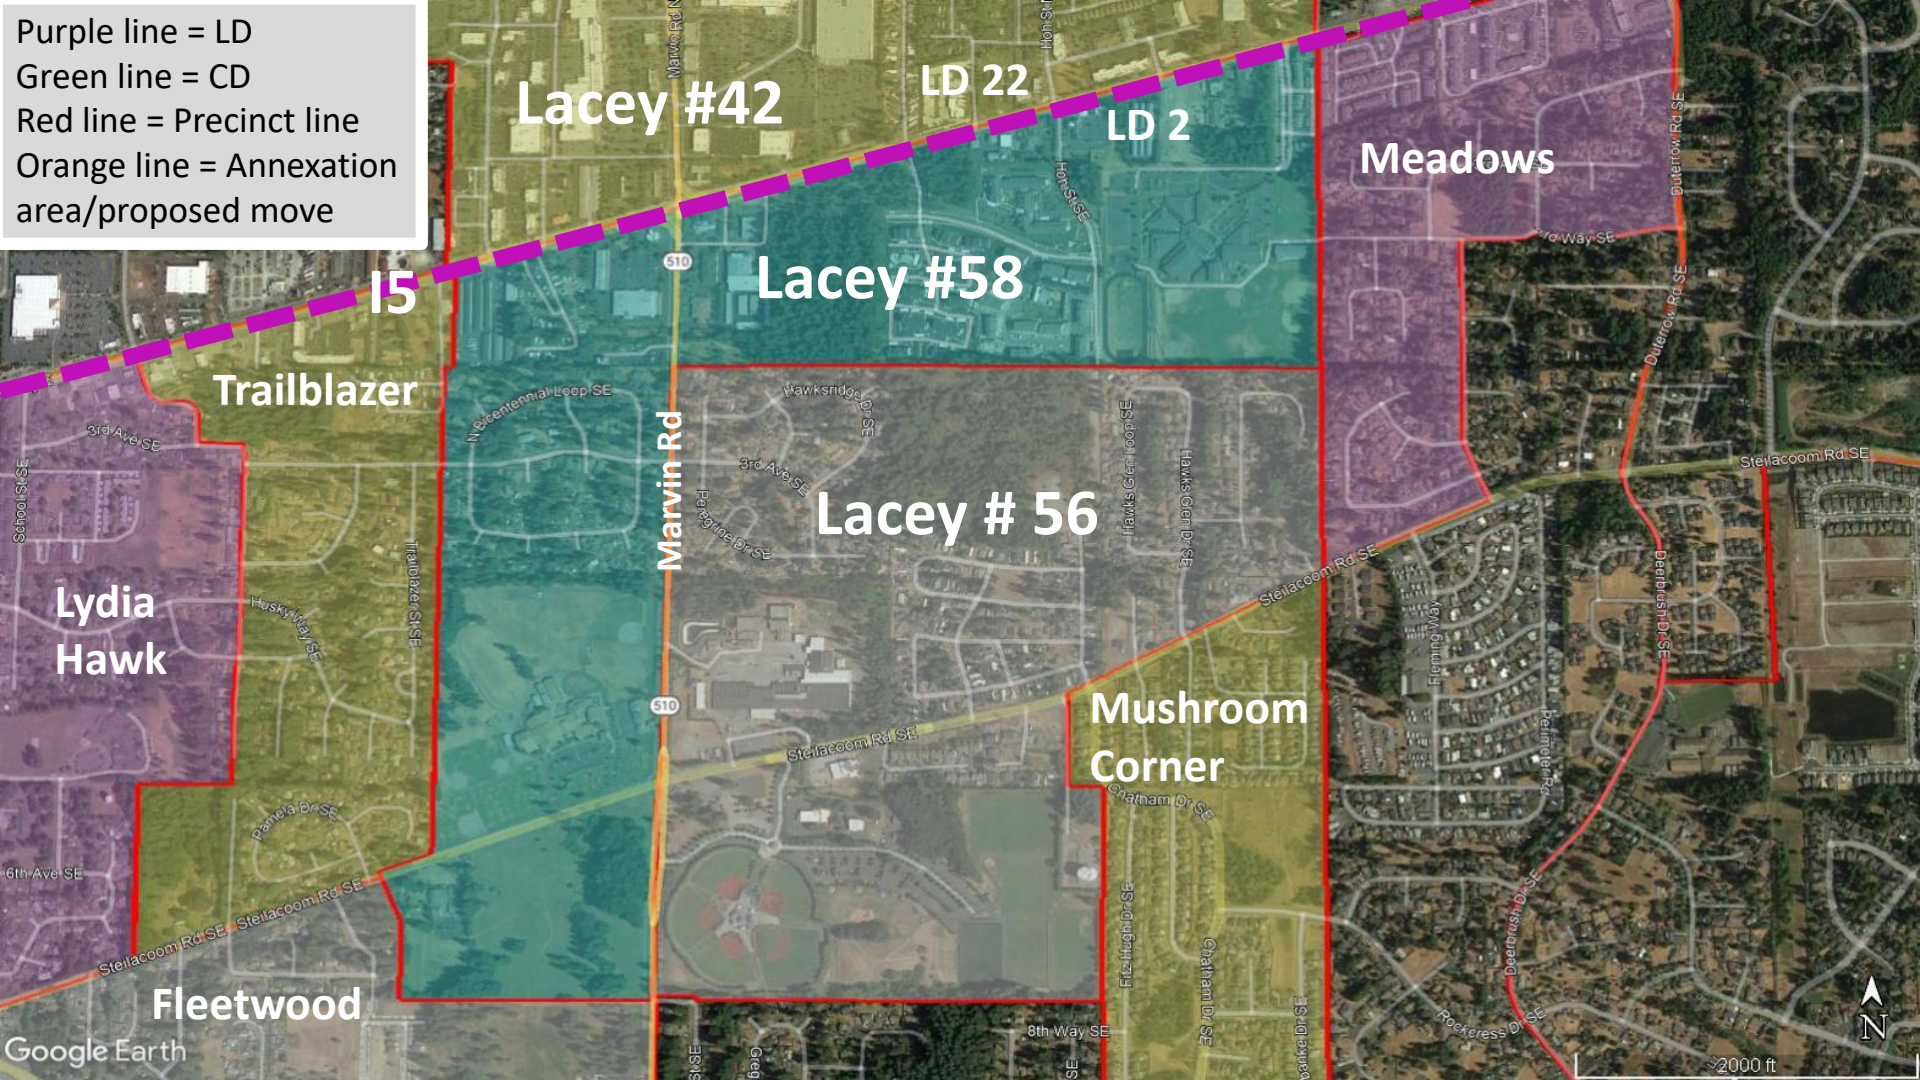

City of Lacey Annexation – Steilacoom/Marvin Rd

- Voter totals for new Lacey #56 (Pct. 356) = 548, and new Lacey #58 (Pct. 358) = 769
- New voter totals for Mushroom Corner (Pct. 92) = 1,080, Trailblazer (Pct. 93) = 569, Fleetwood (Pct. 118) = 1,050, Meadows (Pct. 196) = 699, Lacey #42 (Pct. 342) = 290, Lydia Hawk (Pct. 119) = 1,097

Purple line = LD
 Green line = CD
 Red line = Precinct line
 Orange line = Annexation
 area/proposed move



City of Lacey Annexation – Capitol City/Chambers Estates

- Approx. voter totals of Freedom = 763 and Lacey #32 (Pct. 332) = 1,100
- Entire Freedom (Pct. 123) precinct is annexed, create new Lacey #57 (Pct. 357)
- Split Lacey #32 (Pct. 332) east and west at LD line (LD 2 = east, LD 35 = west)
- Combine Lacey #32 (Pct. 332) in LD 35 with new Lacey #57 (Pct. 357)
- Approx. voters affected = 898

Purple line = LD
Green line = CD
Red line = Precinct line
Orange line = Annexation area/proposed move



City of Lacey Annexation – Capitol City/Chambers Estates

- Voter total for new Lacey #57 (Pct. 357) = 898
- New voter total for Lacey #32 (Pct. 332) = 965

Purple line = LD
 Green line = CD
 Red line = Precinct line
 Orange line = Annexation
 area/proposed move



City of Lacey Annexation – Mosure

- Approx. voter totals of Pattison (Pct. 178) = 821 and Lacey #27 (Pct. 327) = 804
- Annexed area to Lacey #27 (Pct. 327), approx. voters affected = 0
- Split unincorporated Pattison east and west at LD line
- Pattison reformed from area west of LD line, rename as Pattison West (Pct. 178)
- Create new Pattison East (Pct. 23)

Purple line = LD
Green line = CD
Red line = Precinct line
Orange line = Annexation
area/proposed move



City of Lacey Annexation – Mosure

- New voter total for Pattison West (Pct. 178) = 303
- Voter total for new Pattison East (Pct. 23) = 518
- New voter total for Lacey #27 = 804

Purple line = LD
 Green line = CD
 Red line = Precinct line
 Orange line = Annexation area/proposed move



Lacey Area - Kinwood (Pct. 113)


- Legislative District line splits the precinct
- Approx. voter total of Kinwood = 694
- Split Kinwood east and west at LD line (which follows Kinwood St)
- Reform Kinwood from area west of LD line, rename as Kinwood West (Pct. 113)
- Create new Kinwood East (Pct. 24) from area east of LD line

Purple line = LD
Green line = CD
Red line = Precinct line
Orange line = Annexation area/proposed move




Lacey Area - Kinwood (Pct. 113)

- New voter total of Kinwood West (Pct. 113) = 163
- Voter total of new Kinwood East (Pct. 24) = 531

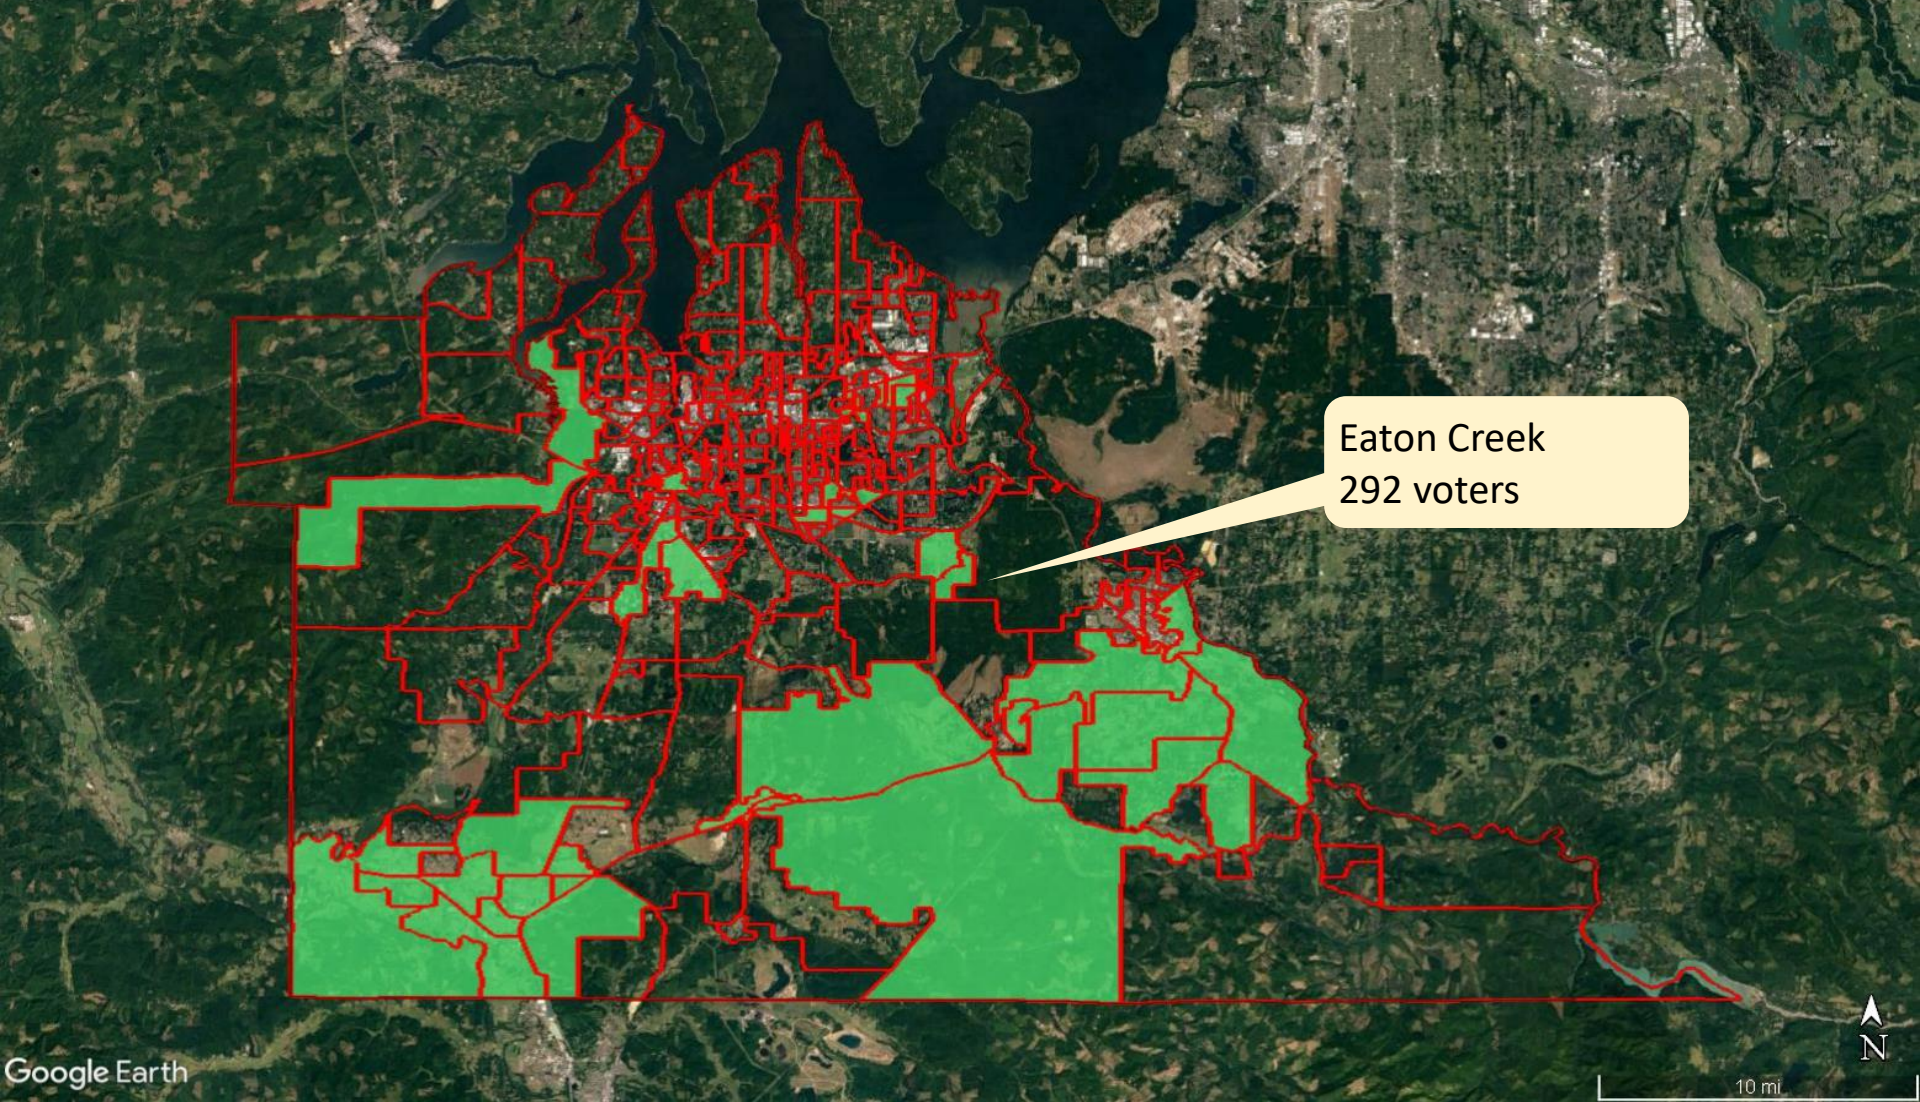


Eaton Creek (Pct. 166)

- Legislative District line splits the precinct
- Approx. voter total of Eaton Creek = 423
- Approx. voters affected = 292

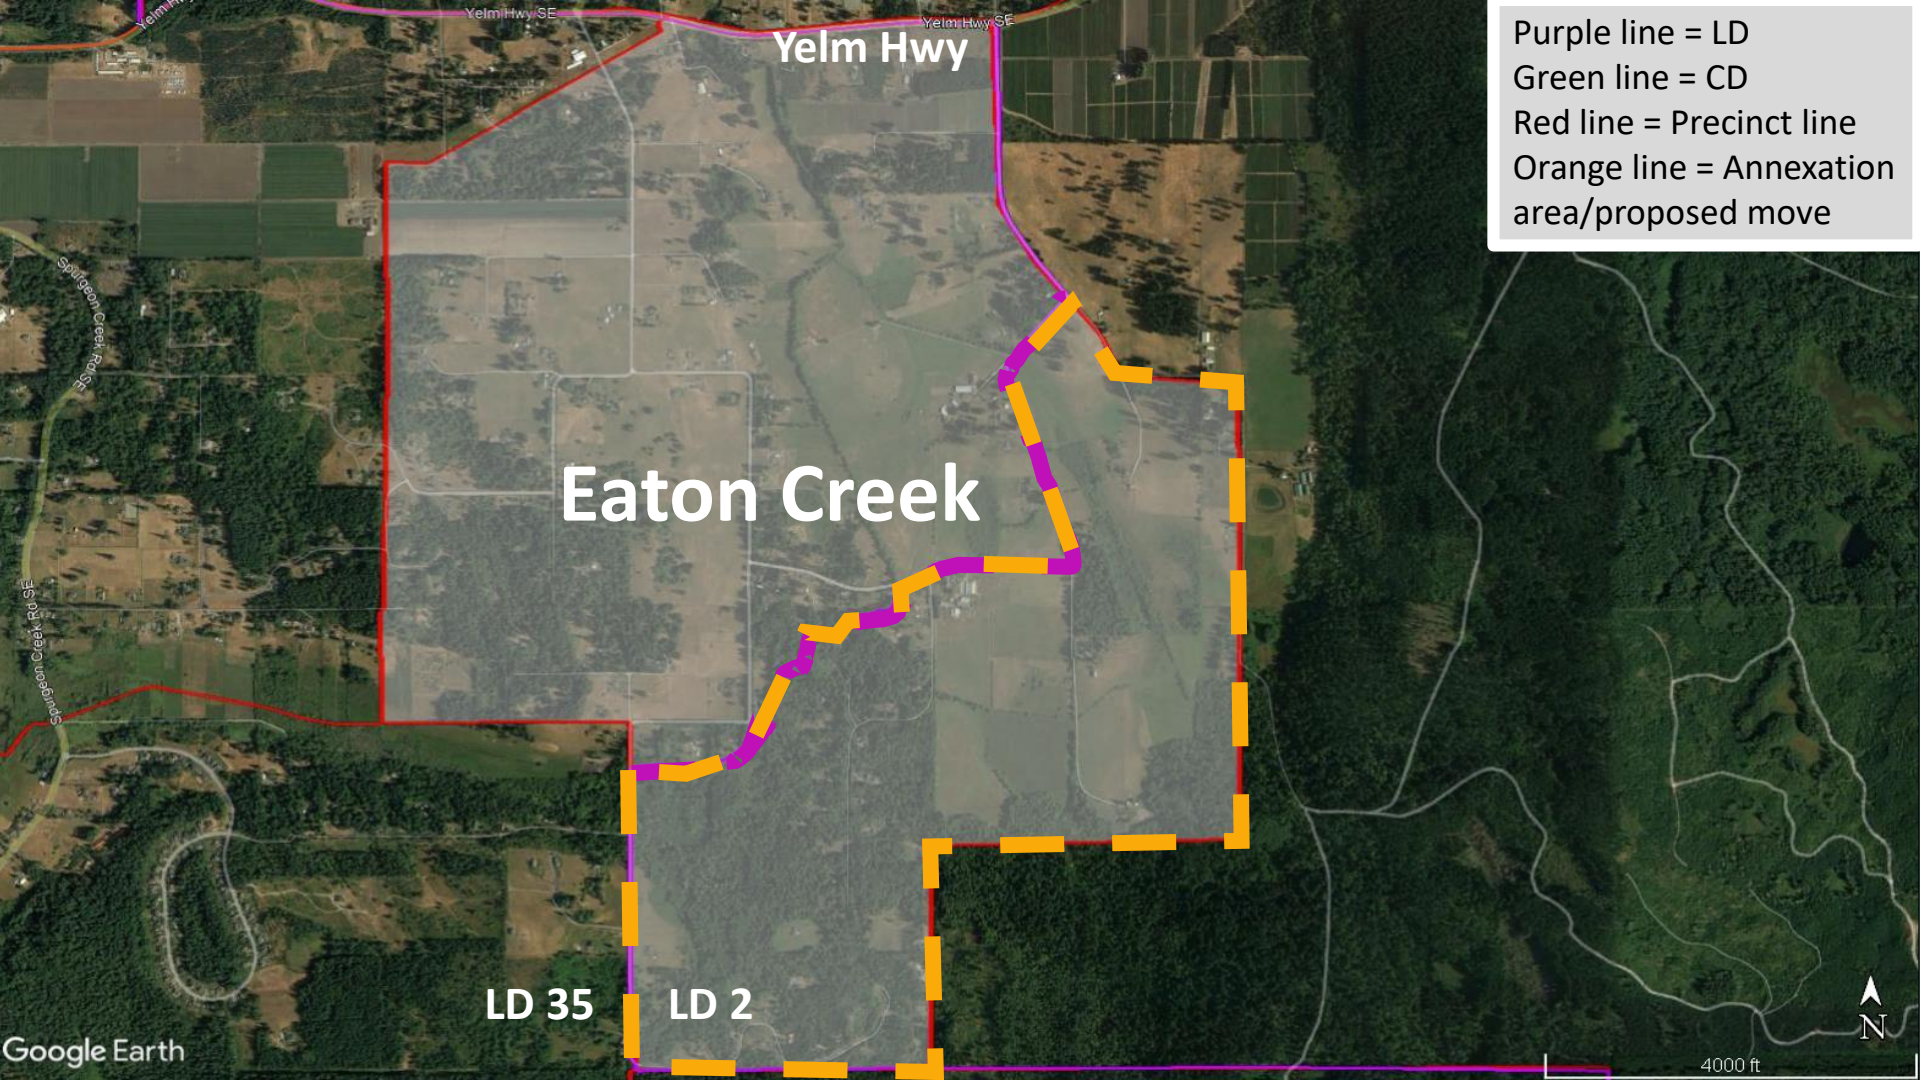


Eaton Creek (Pct. 166)

- Split Eaton Creek north and south at LD line (LD 2 = south, LD 35 = north)
- Eaton Creek reformed from area south of LD line, rename as Eaton Creek South (Pct. 166)
- Create new Eaton Creek North (Pct. 22) from area north of LD line

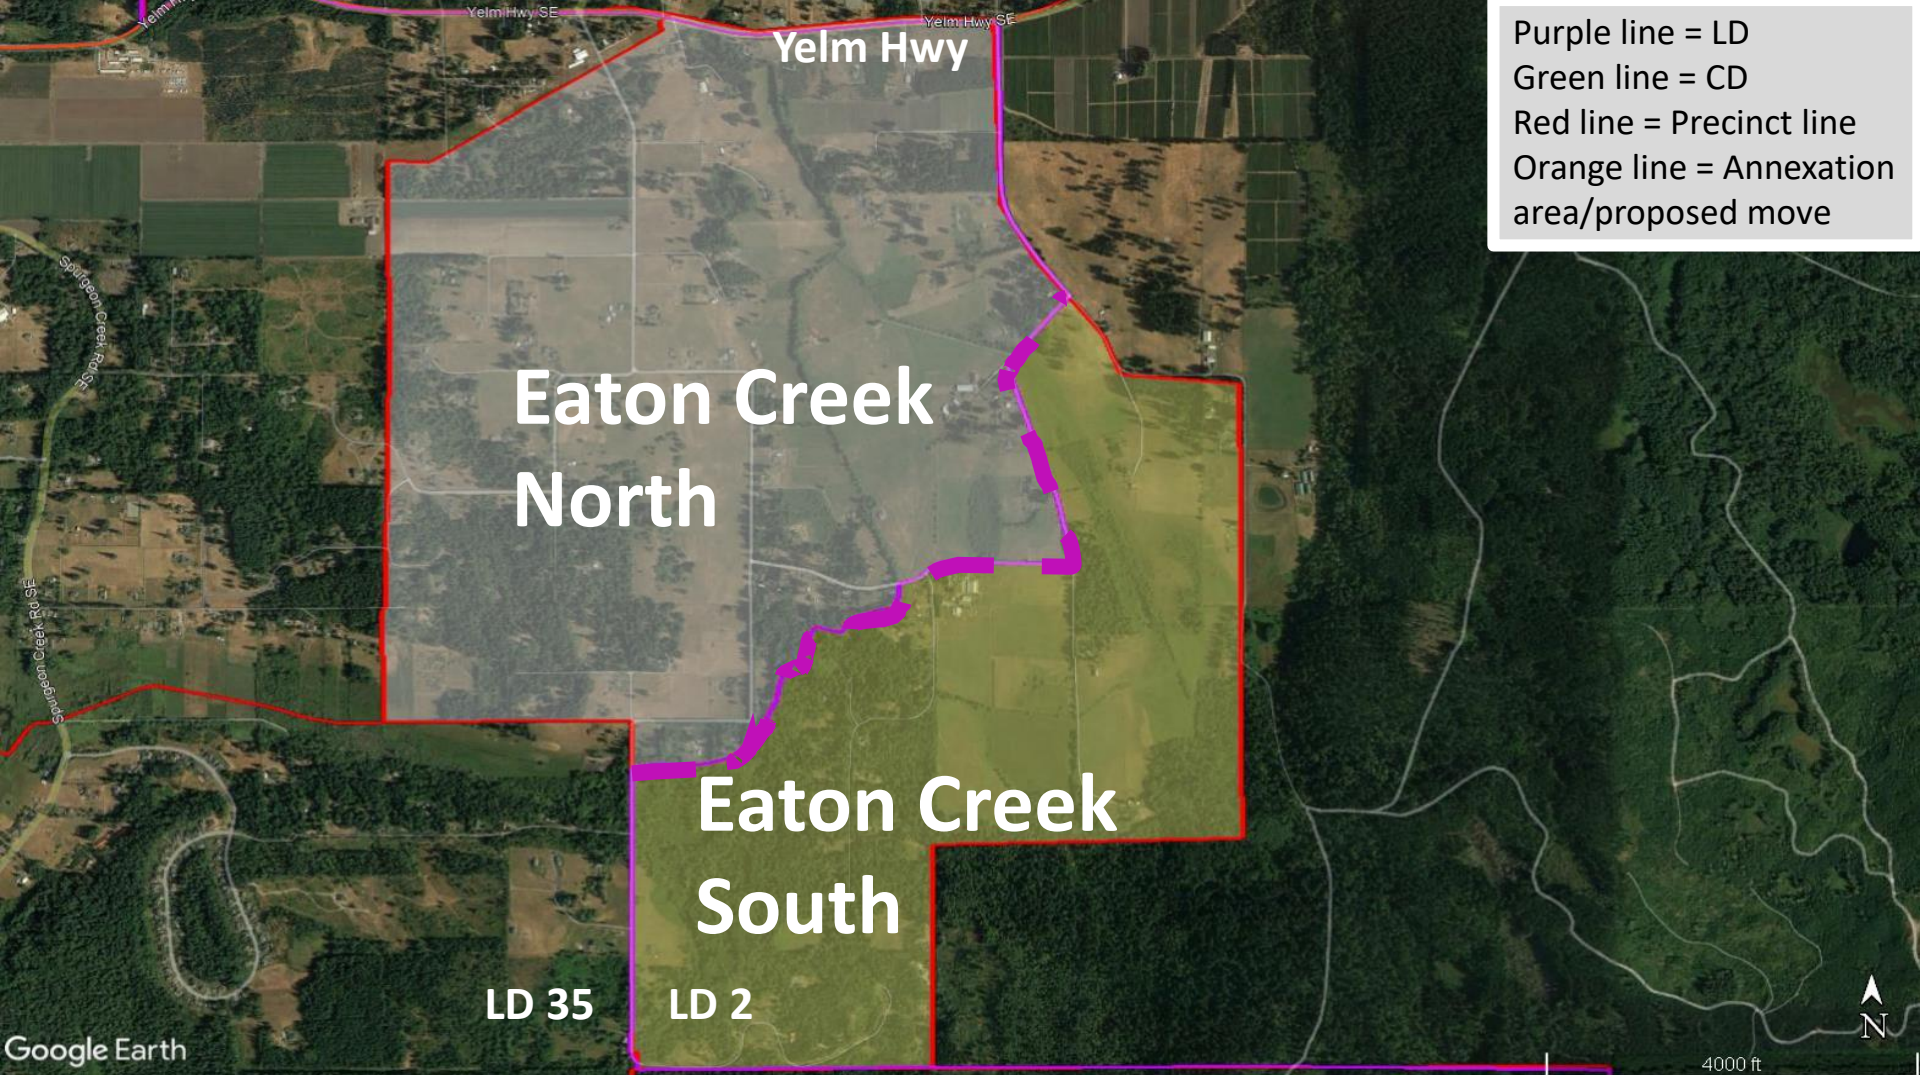


Eaton Creek (Pct. 166)

- New voter total of Eaton Creek South (Pct. 166) = 131
- Voter total of new Eaton Creek North (Pct. 22) = 292

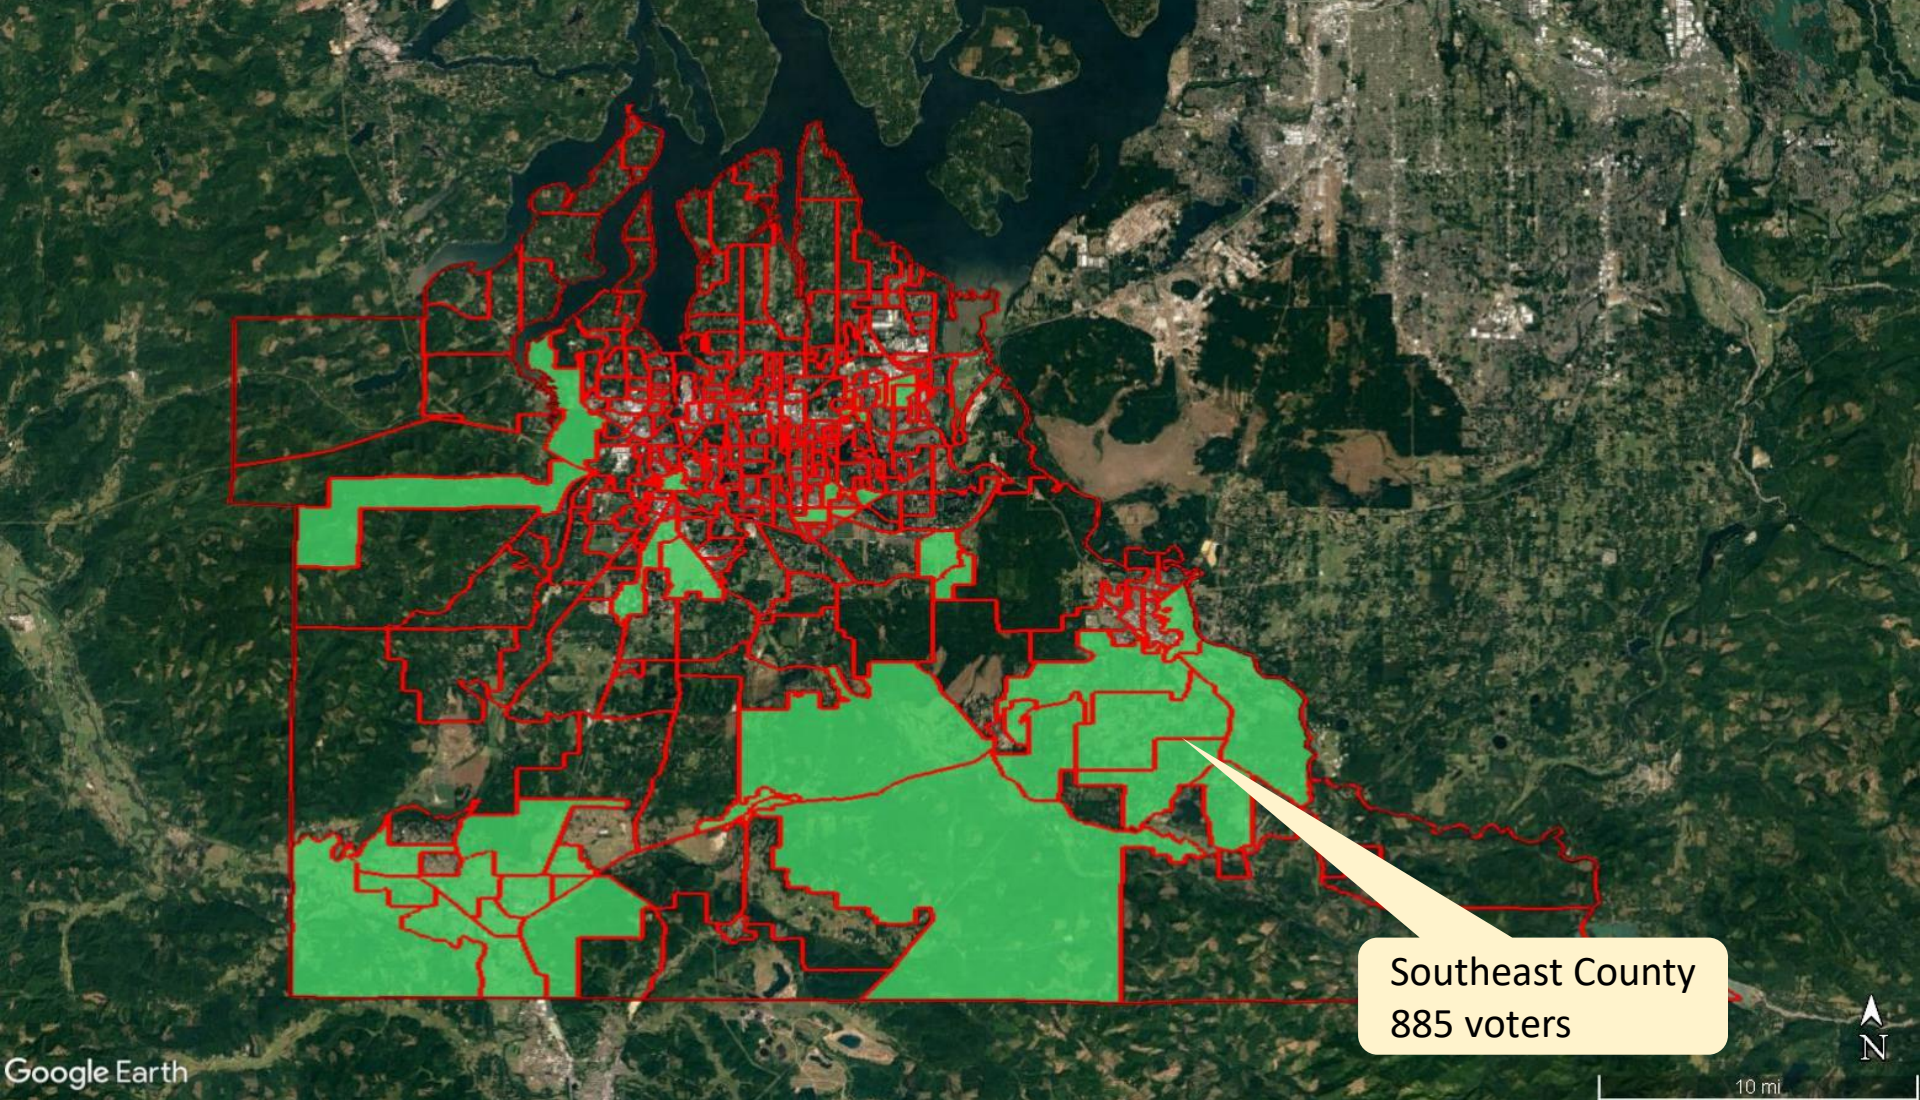


Southeast County

- Congressional and Legislative District lines split 5 precincts
- One city boundary adjustment
- Approx. voters affected = 885

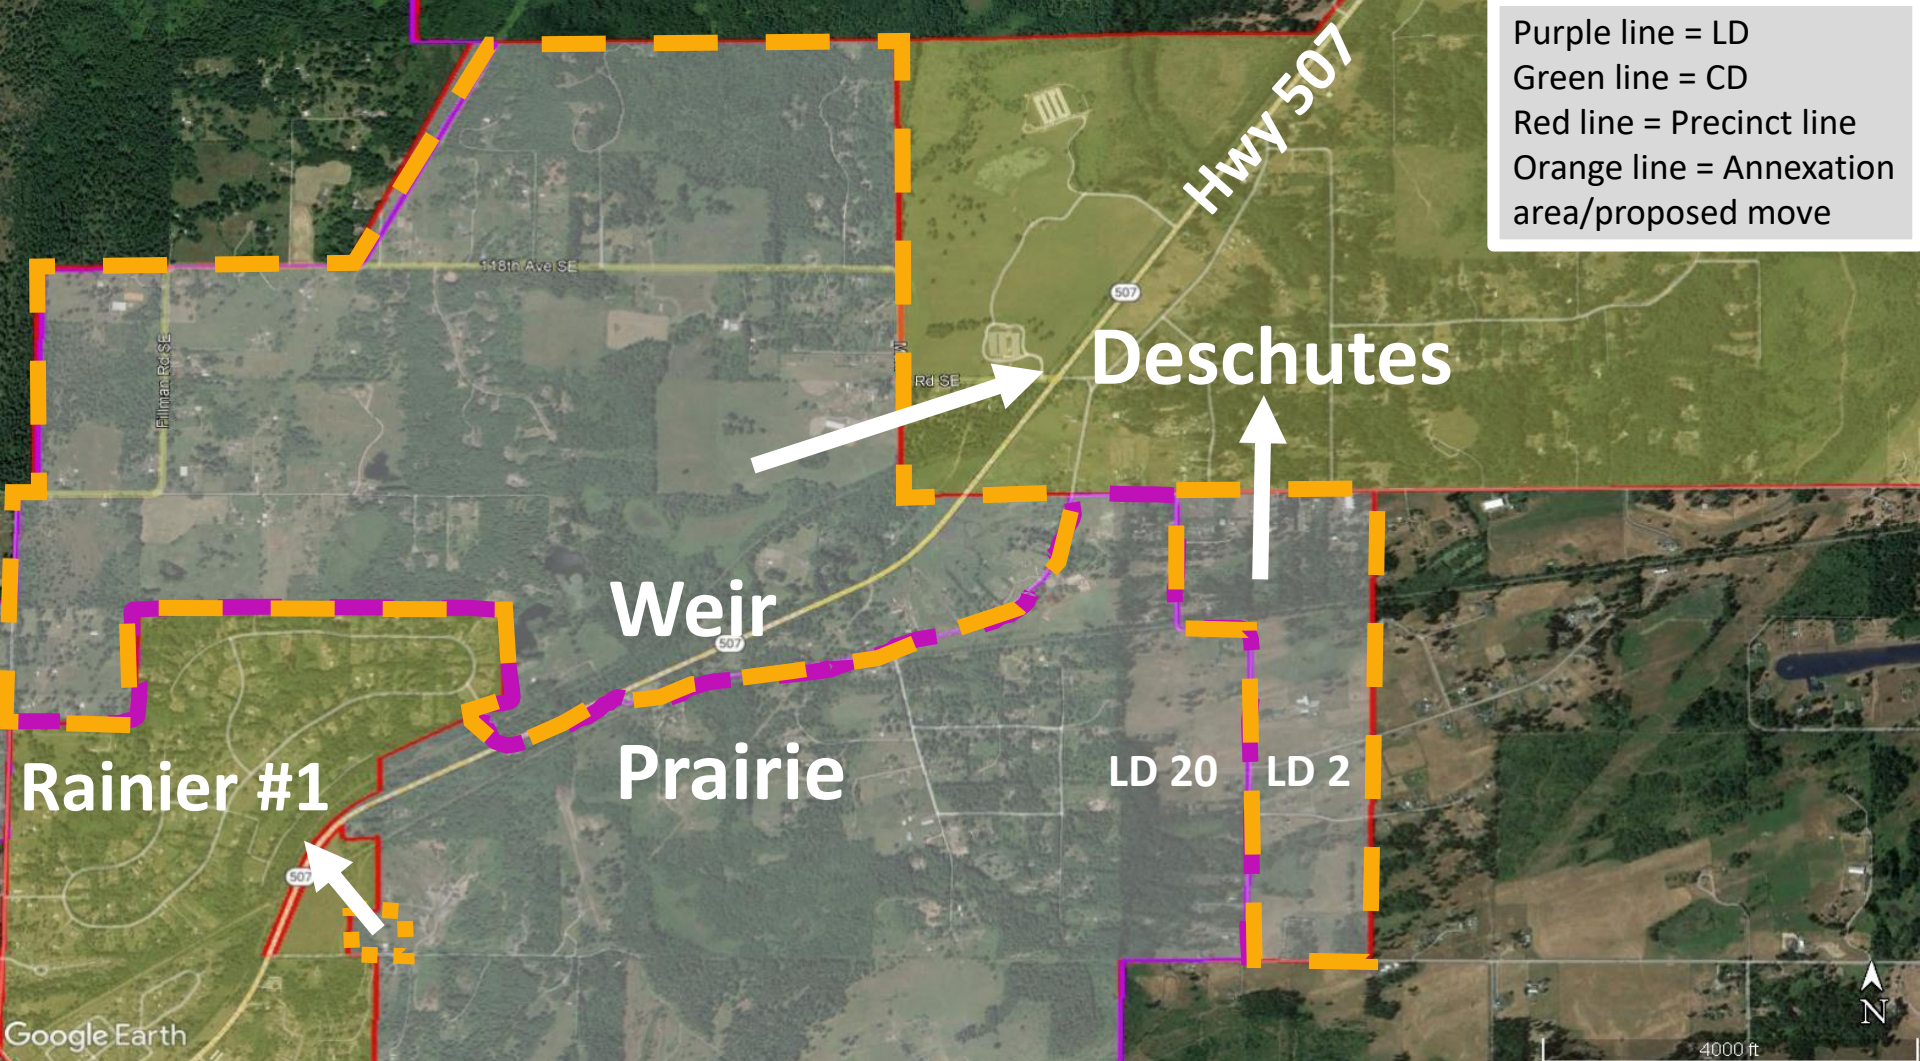


SE County - Rainier #1 (Pct. 601), Weir Prairie (Pct. 128), and Deschutes (Pct. 125)

- Approx. voter totals of Rainier #1 = 866, Weir Prairie = 781, and Deschutes = 992
- City of Rainier boundary adjustment – add area to Rainier #1 (Pct. 601)
- Split Weir Prairie along LD line, Weir Prairie reformed from area south of LD line
- Combine Weir Prairie (Pct. 128) in LD 2 with Deschutes (Pct. 125)
- Approx. voters affected = 350

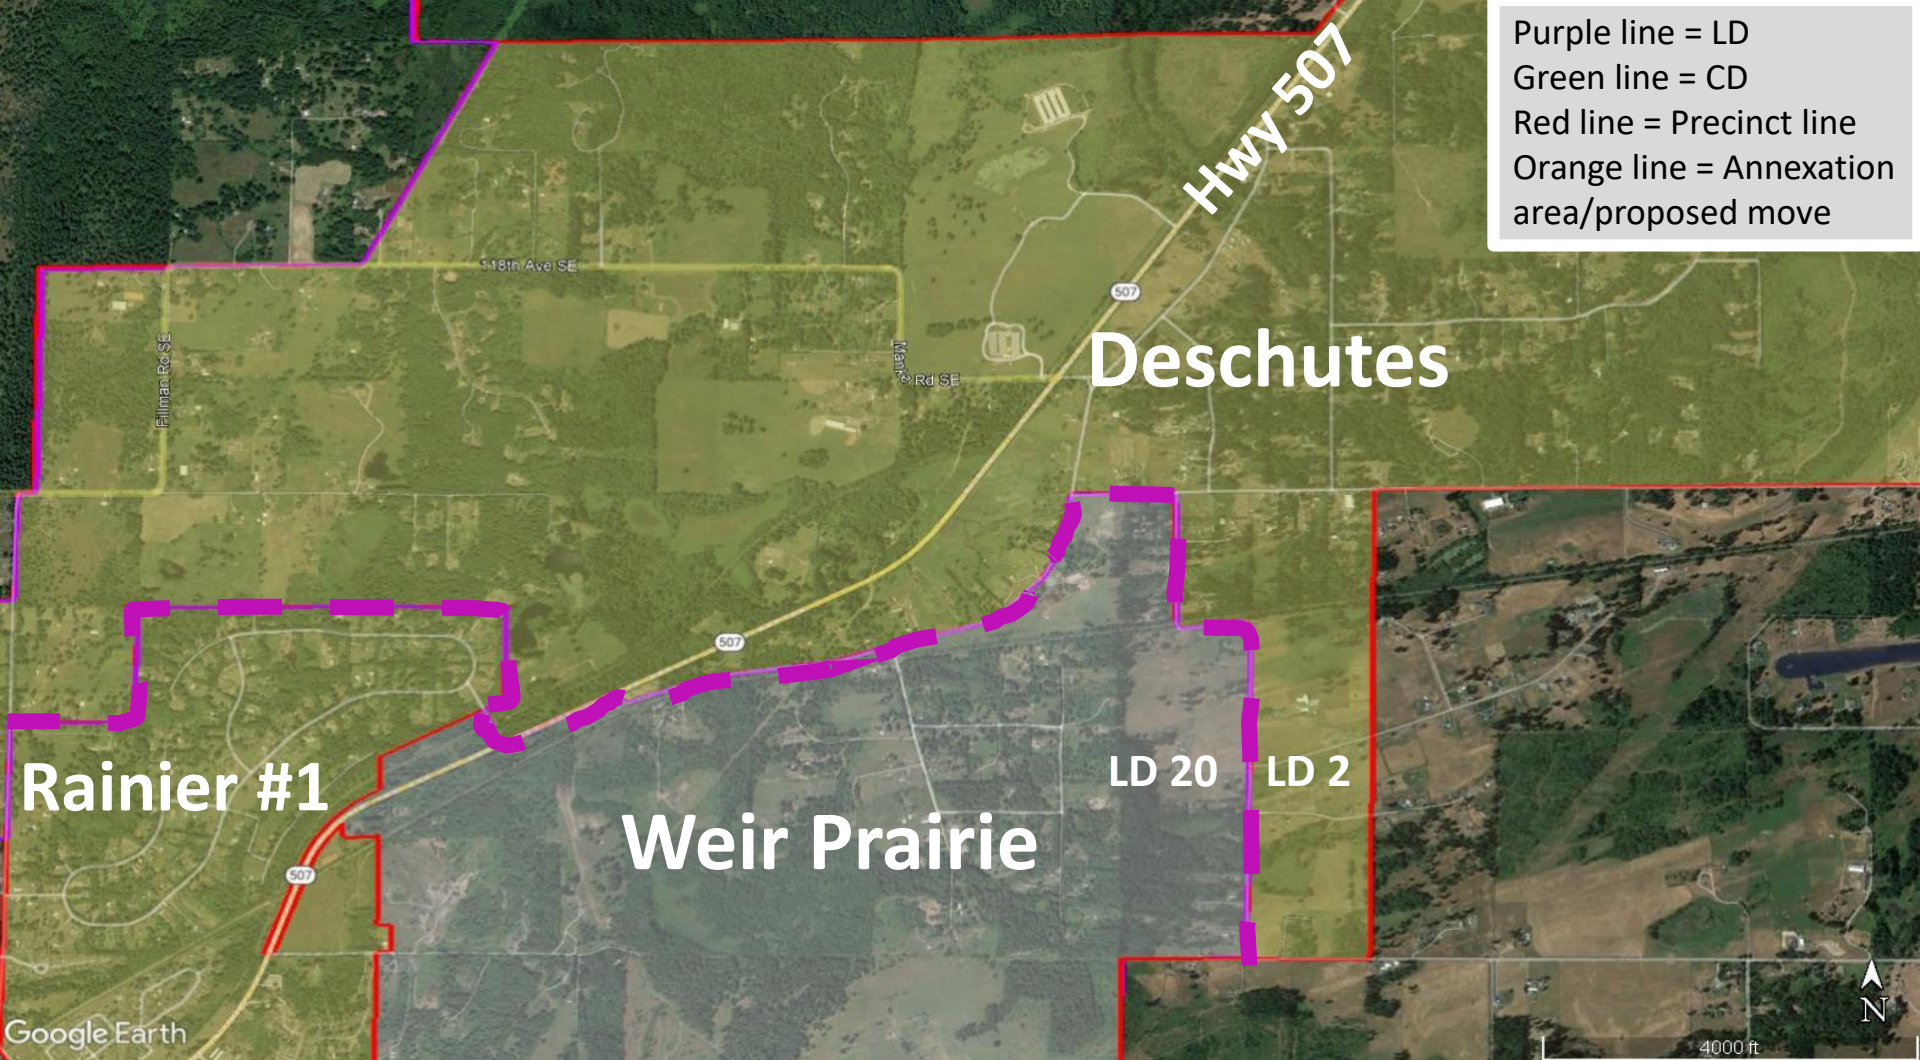


SE County - Rainier #1 (Pct. 601), Weir Prairie (Pct. 128), and Deschutes (Pct. 125)

- New voter total of Rainier #1 (Pct. 601) = 866
- New voter total of Weir Prairie (Pct. 128) = 431
- New temporary voter total of Deschutes (Pct. 125) = 1,342

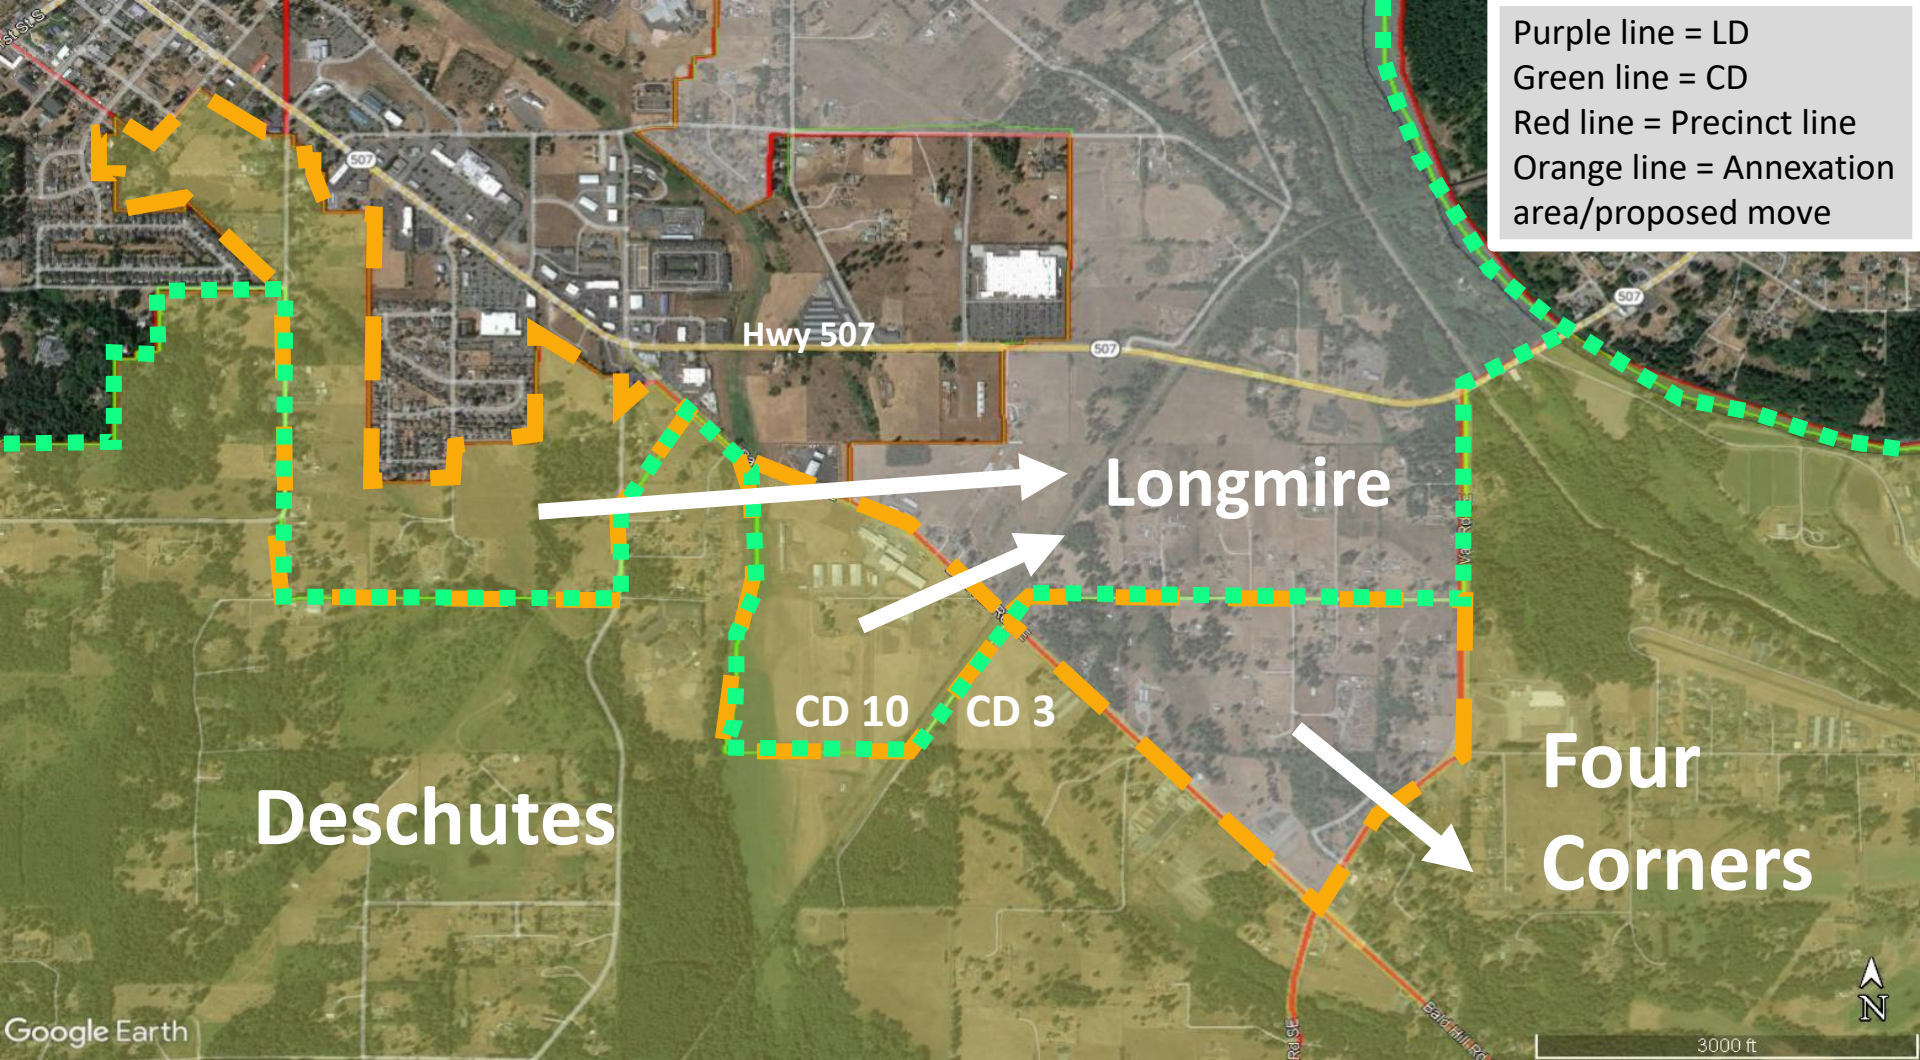


SE County - Deschutes (Pct. 125), Longmire (Pct. 126), and Four Corners (Pct. 179)

- Approx. voter totals of Deschutes = 992, Longmire = 630, and Four Corners = 1,324
- Split Deschutes (Pct. 125) at CD line and combine CD 10 area with Longmire (Pct. 126)
- Split Longmire (Pct. 126) at CD line and combine CD 3 area with Four Corners (Pct. 179)
- Approx. voters affected = 148

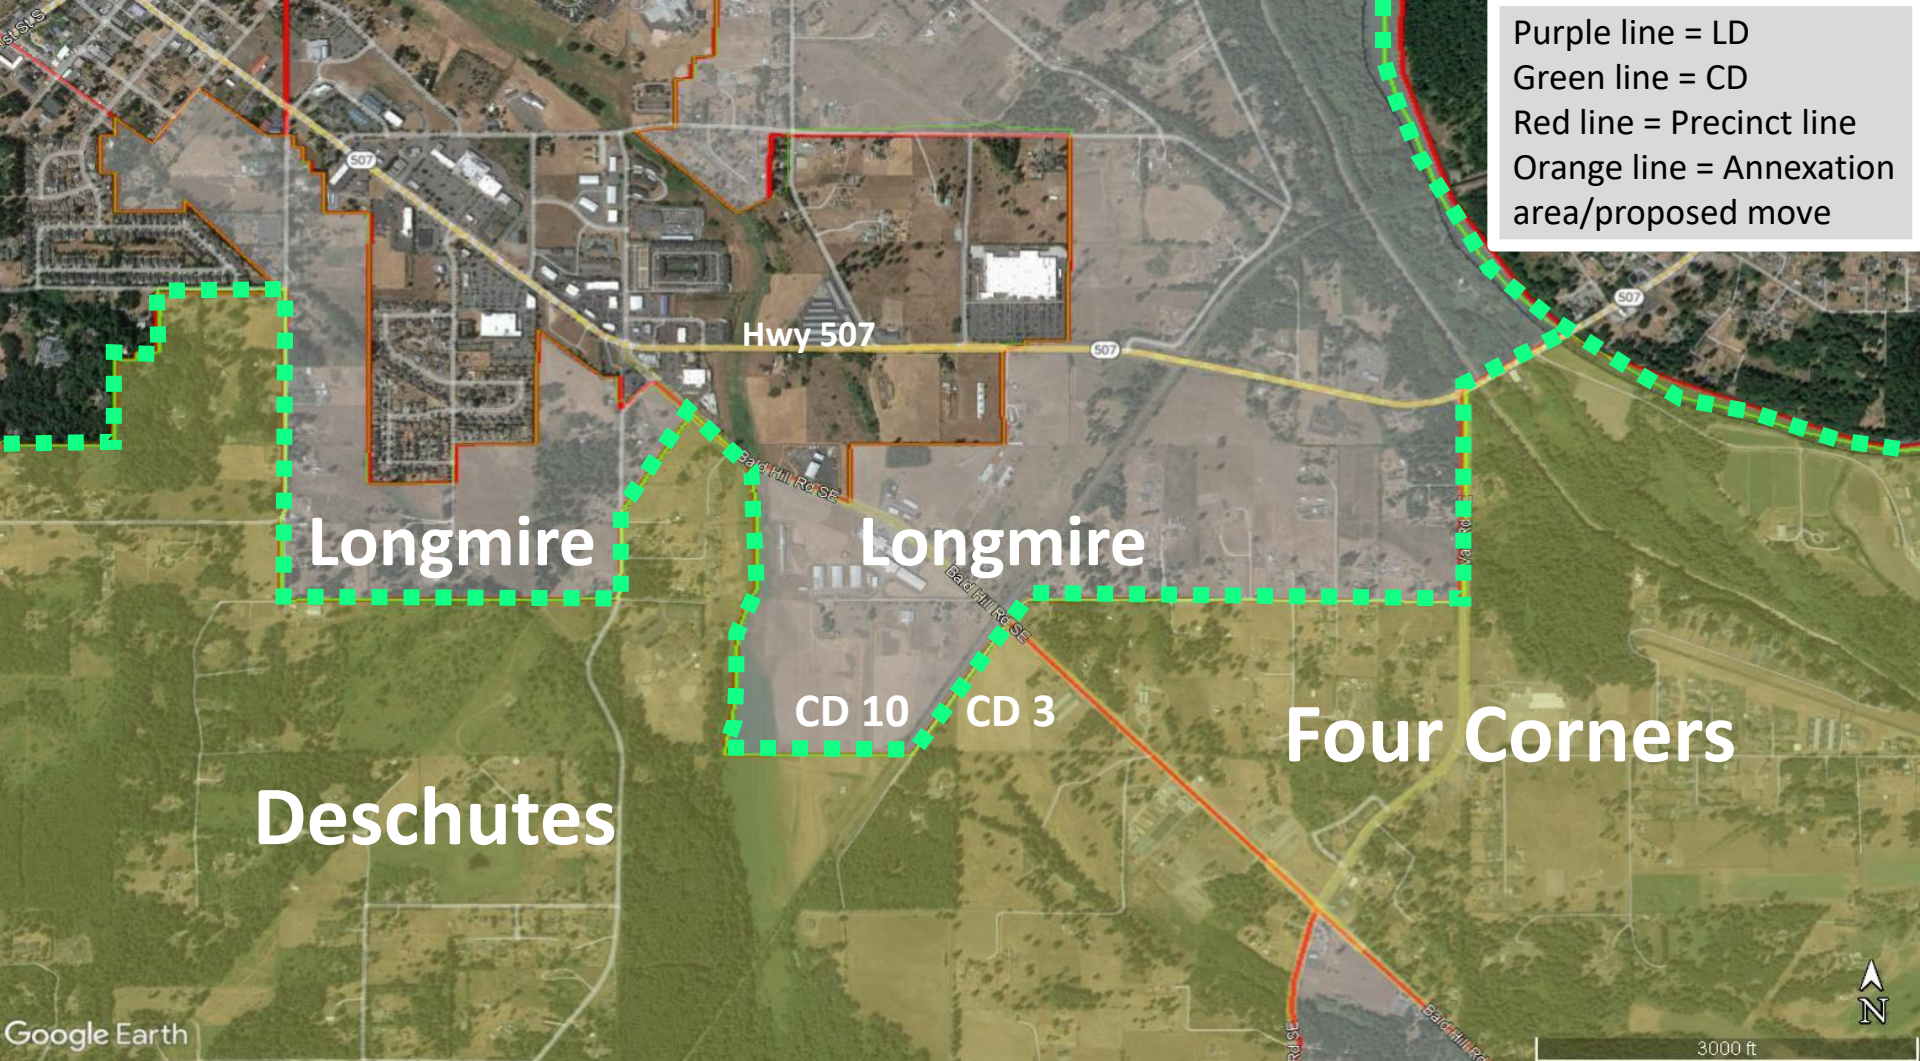


Deschutes (Pct. 125), Longmire (Pct. 126), and Four Corners (Pct. 179)

- New (final) voter total of Deschutes (Pct. 125) = 1,261
- New voter total of Longmire (Pct. 126) = 644
- New temporary voter total of Four Corners (Pct. 179) = 1,391

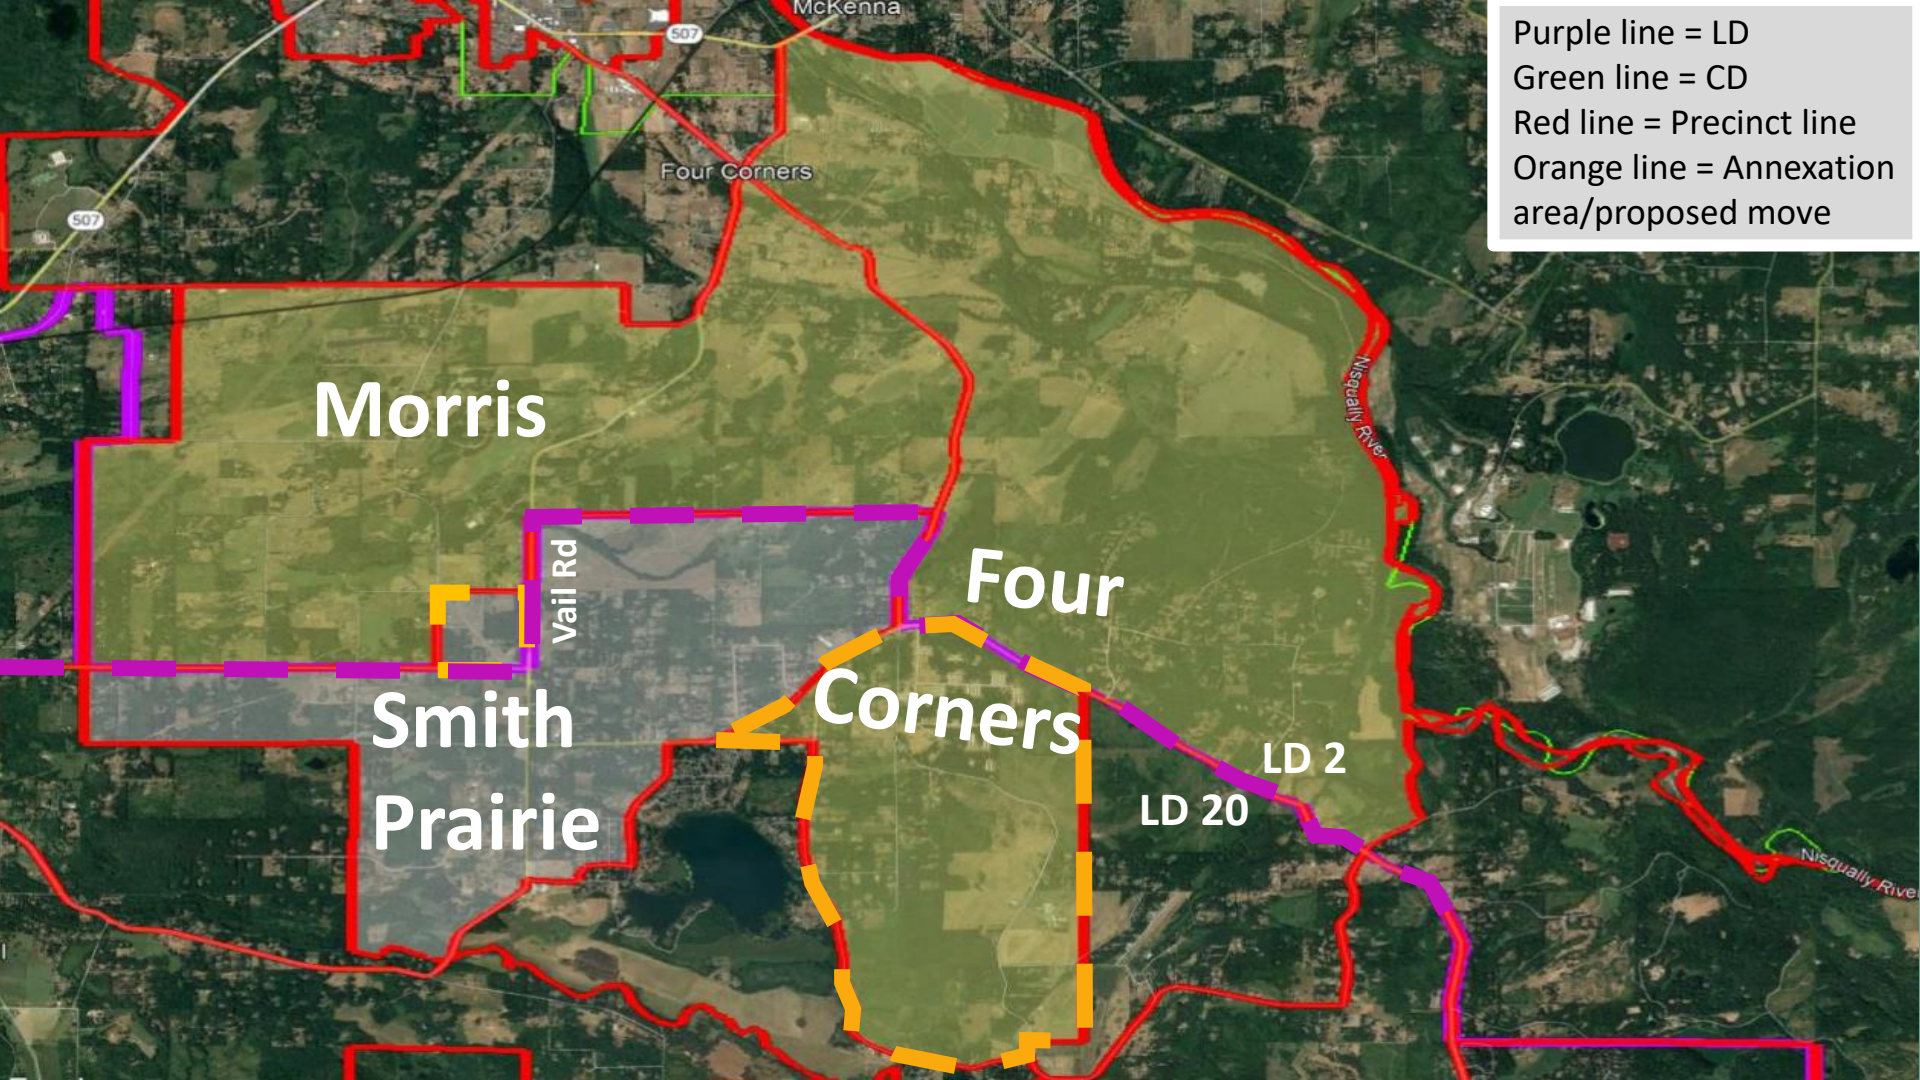


Morris (Pct. 32), Smith Prairie (Pct. 60), and Four Corners (Pct. 179)

- Approx. voter totals of Morris = 922, Smith Prairie = 1,086, and Four Corners = 1,391
- Split Smith Prairie at LD line and combine LD 2 area with Morris
- Split Four Corners north and south of LD line and reform from area north of LD line, rename as Four Corners North (Pct. 179)
- Create new Four Corners South (Pct. 19) from area south of LD line

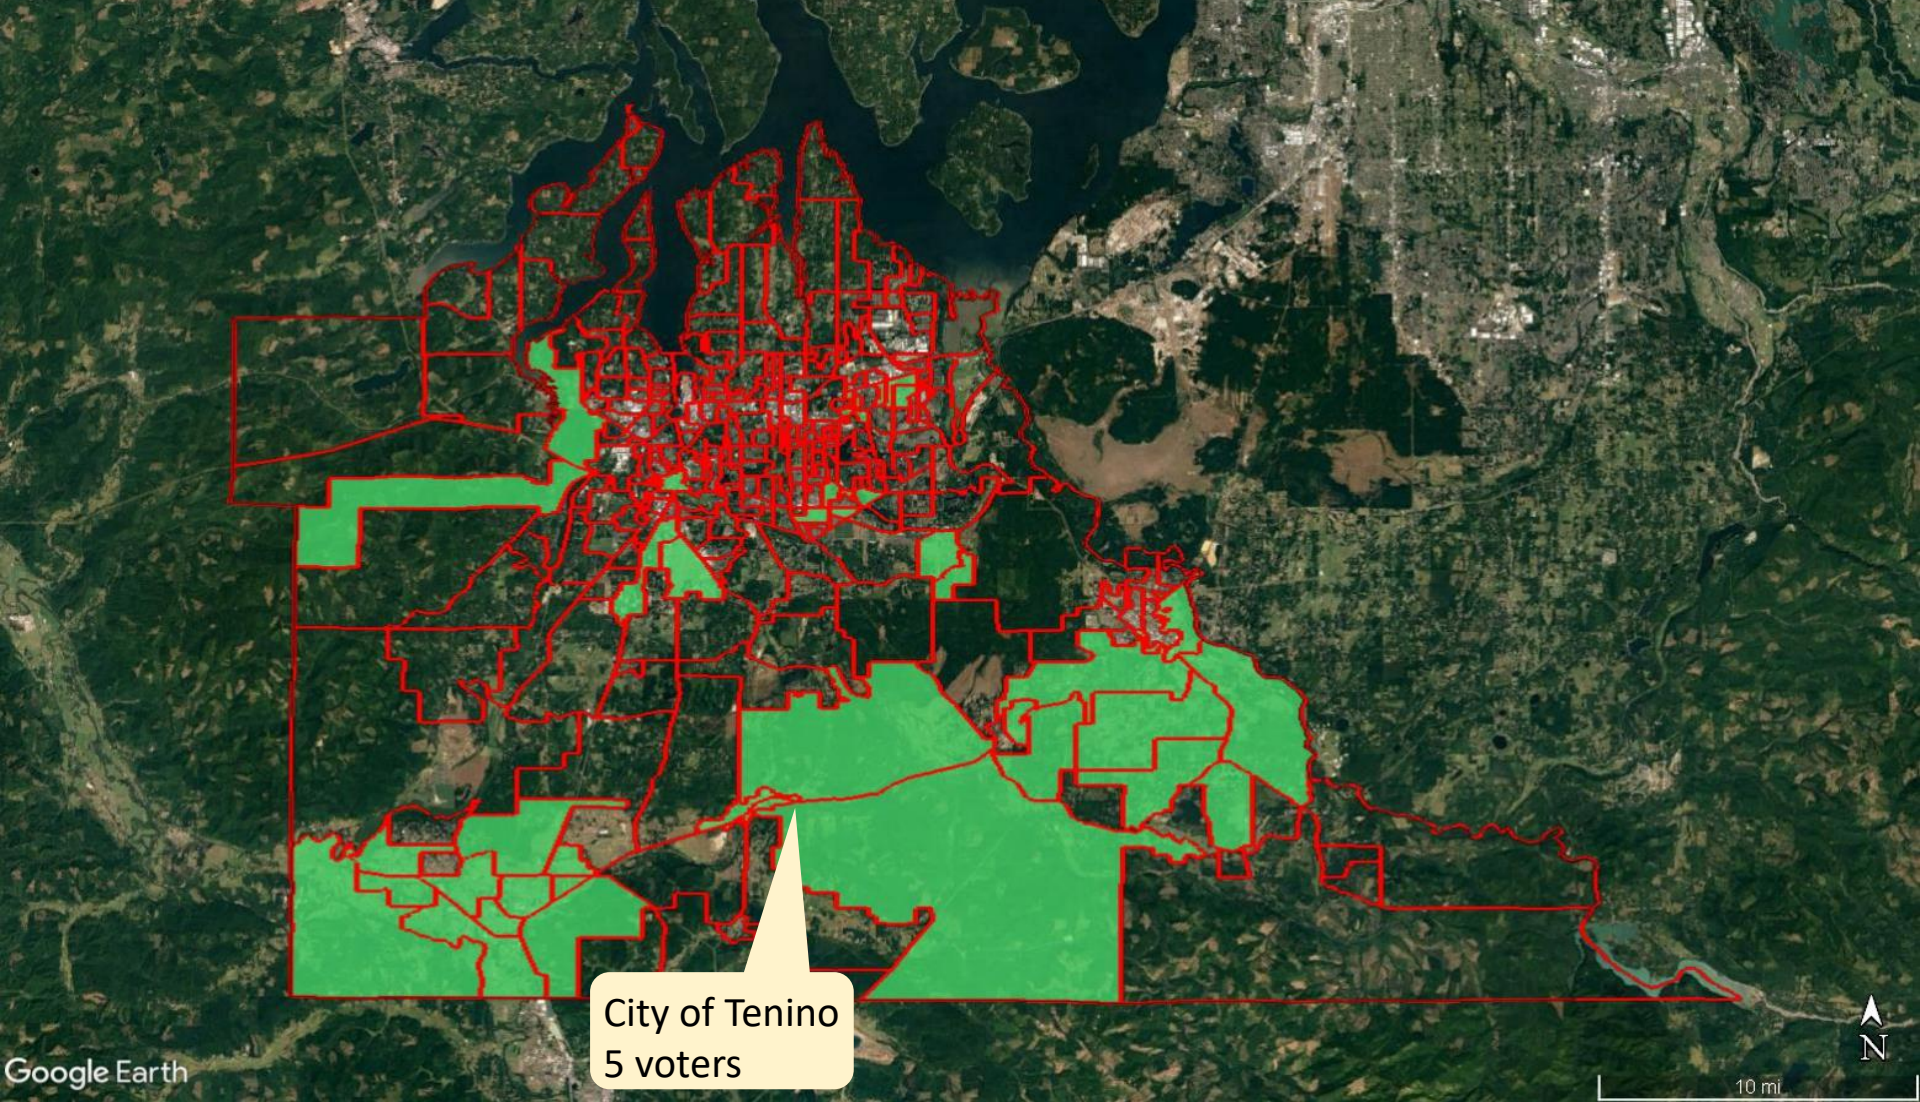


City of Tenino

- Adjustment due to Congressional District line
- Approx. voters affected = 5

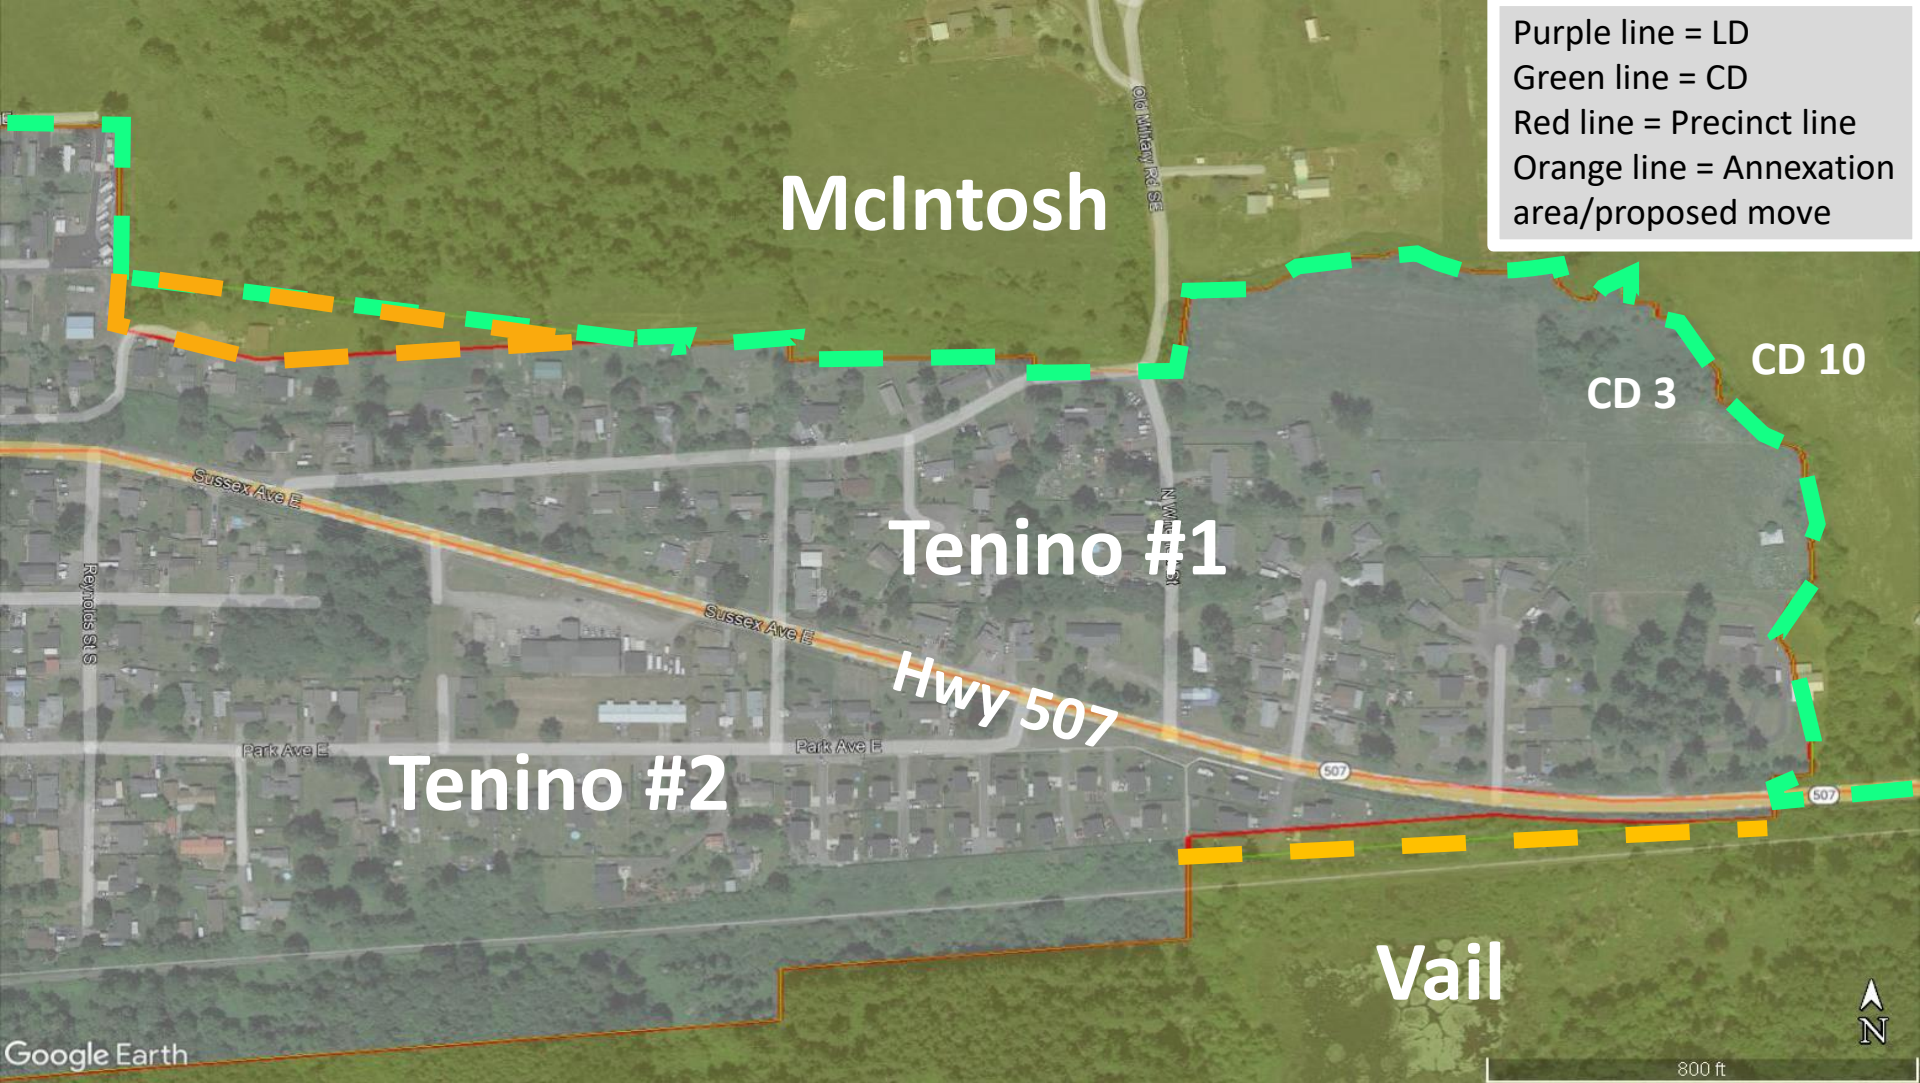


City of Tenino

- Approx. voter totals of McIntosh (Pct. 149) = 1,370, Vail (Pct. 53) = 922, Tenino #1 (Pct. 501) = 616, Tenino #2 (Pct. 502) = 590
- Tenino #1 (Pct. 502) boundary to follow CD line
- Tenino #2 (Pct. 502) boundary to follow city limits
- Approx. voters affected = 5

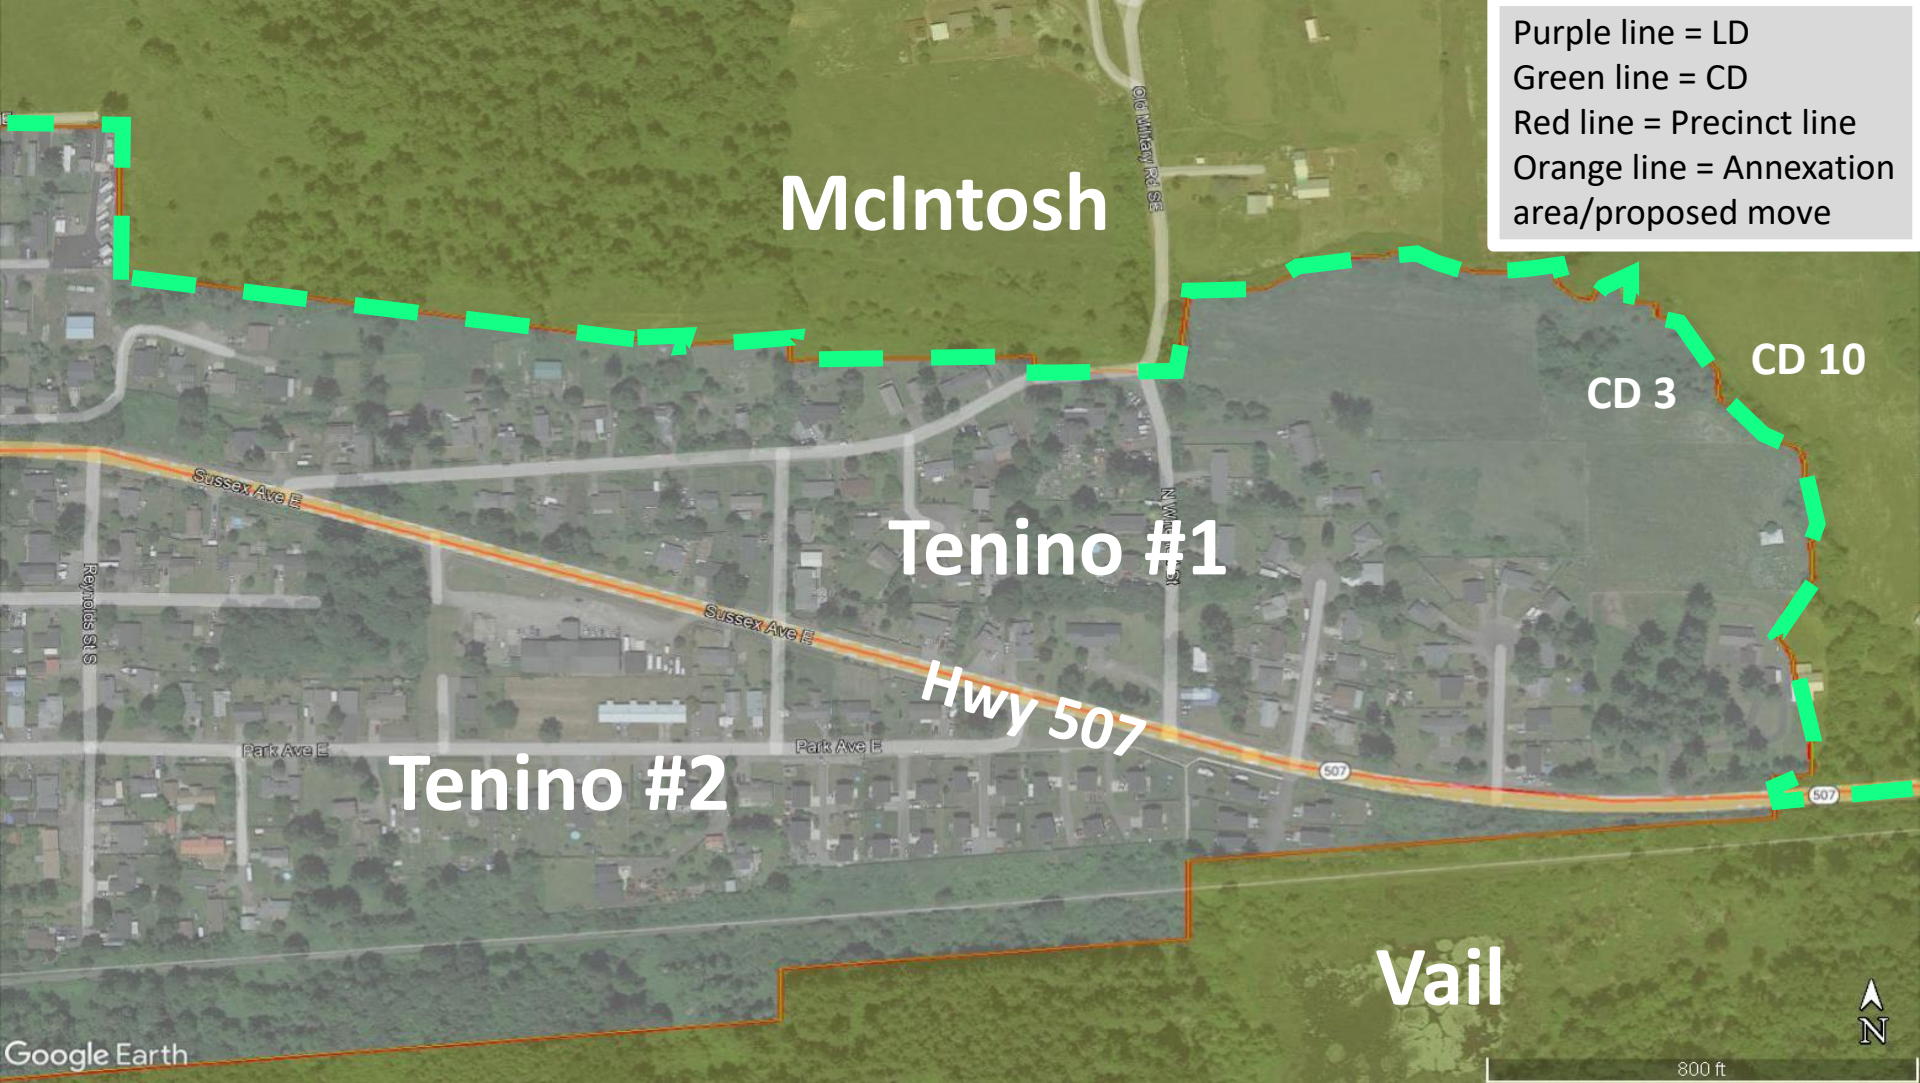

City of Tenino


- New voter total of McIntosh (Pct. 149) = 1,369
- New voter total of Vail (Pct. 53) = 918
- New voter total of Tenino #1 (Pct. 502) = 617
- New voter total of Tenino #2 (Pct. 502) = 594

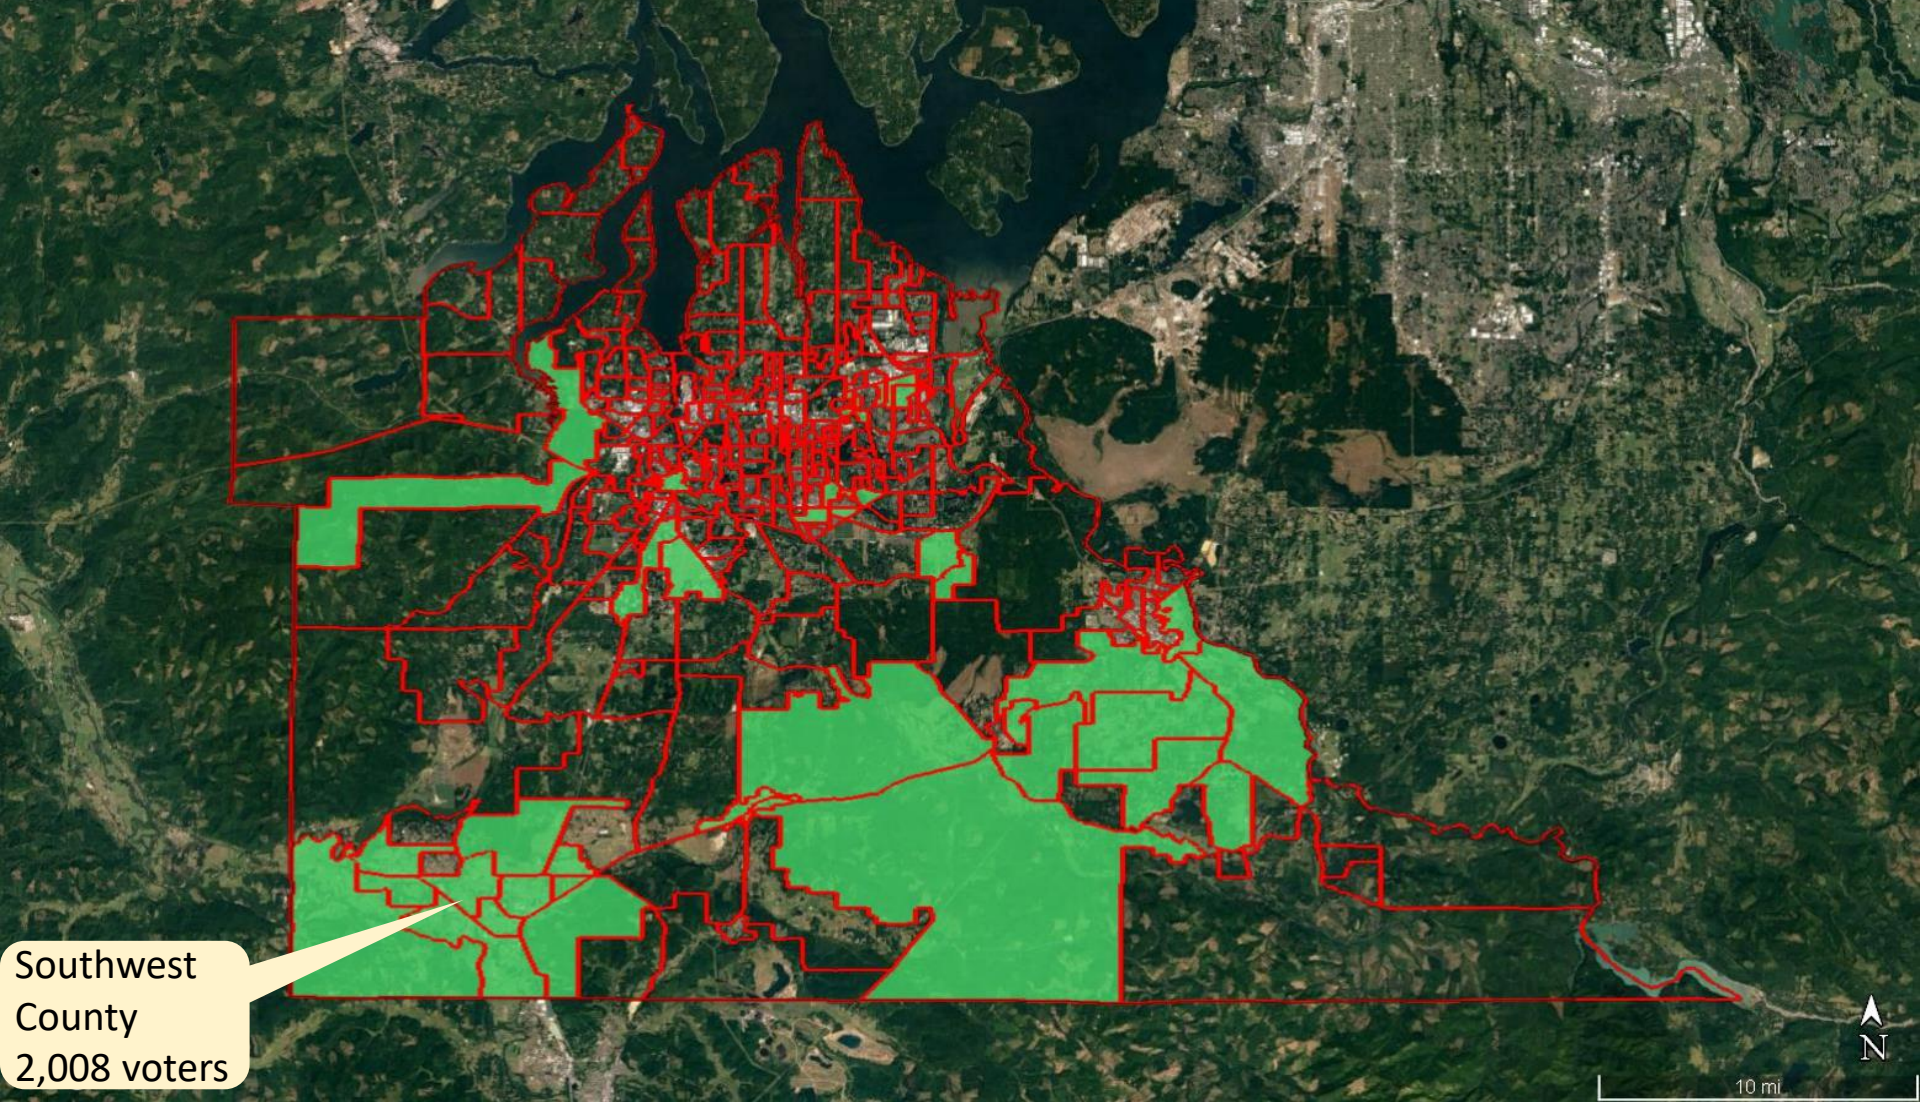

Southwest
County
2,008 voters


Southwest County

- Congressional and Legislative District lines split 9 precincts
- Approx. voters affected = 2,008

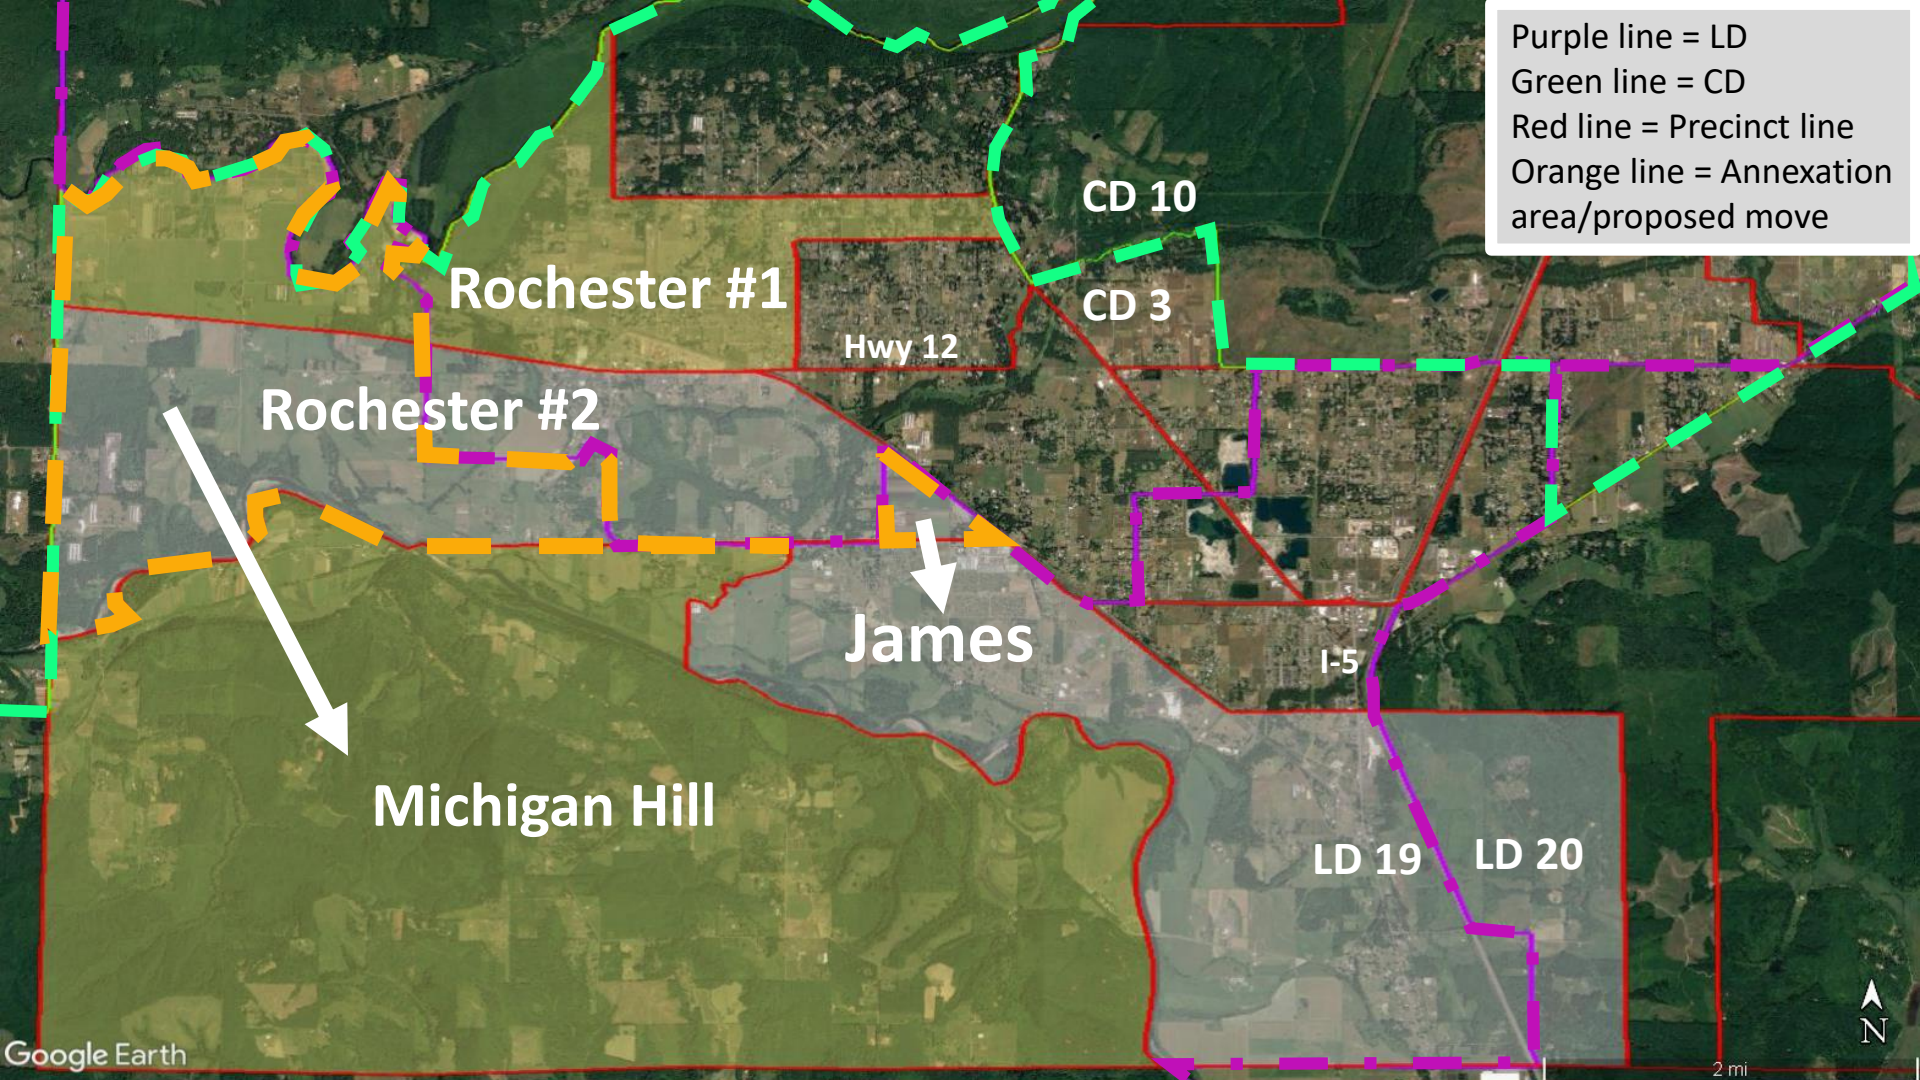


Michigan Hill (Pct. 48), Rochester #1 (Pct. 153), Rochester #2 (Pct. 154), and James (Pct. 52)

- Approx. voter totals of Michigan Hill = 422, Rochester #1 = 1,142, Rochester #2 = 793, James = 800
- Split Rochester #1 east and west, and Rochester #2 on the east and west side at the LD line
- Combine west areas of Rochester #1 and #2 in LD 19 with Michigan Hill (Pct. 48)
- Combine east area of Rochester #2 in LD 19 with James (Pct. 52)

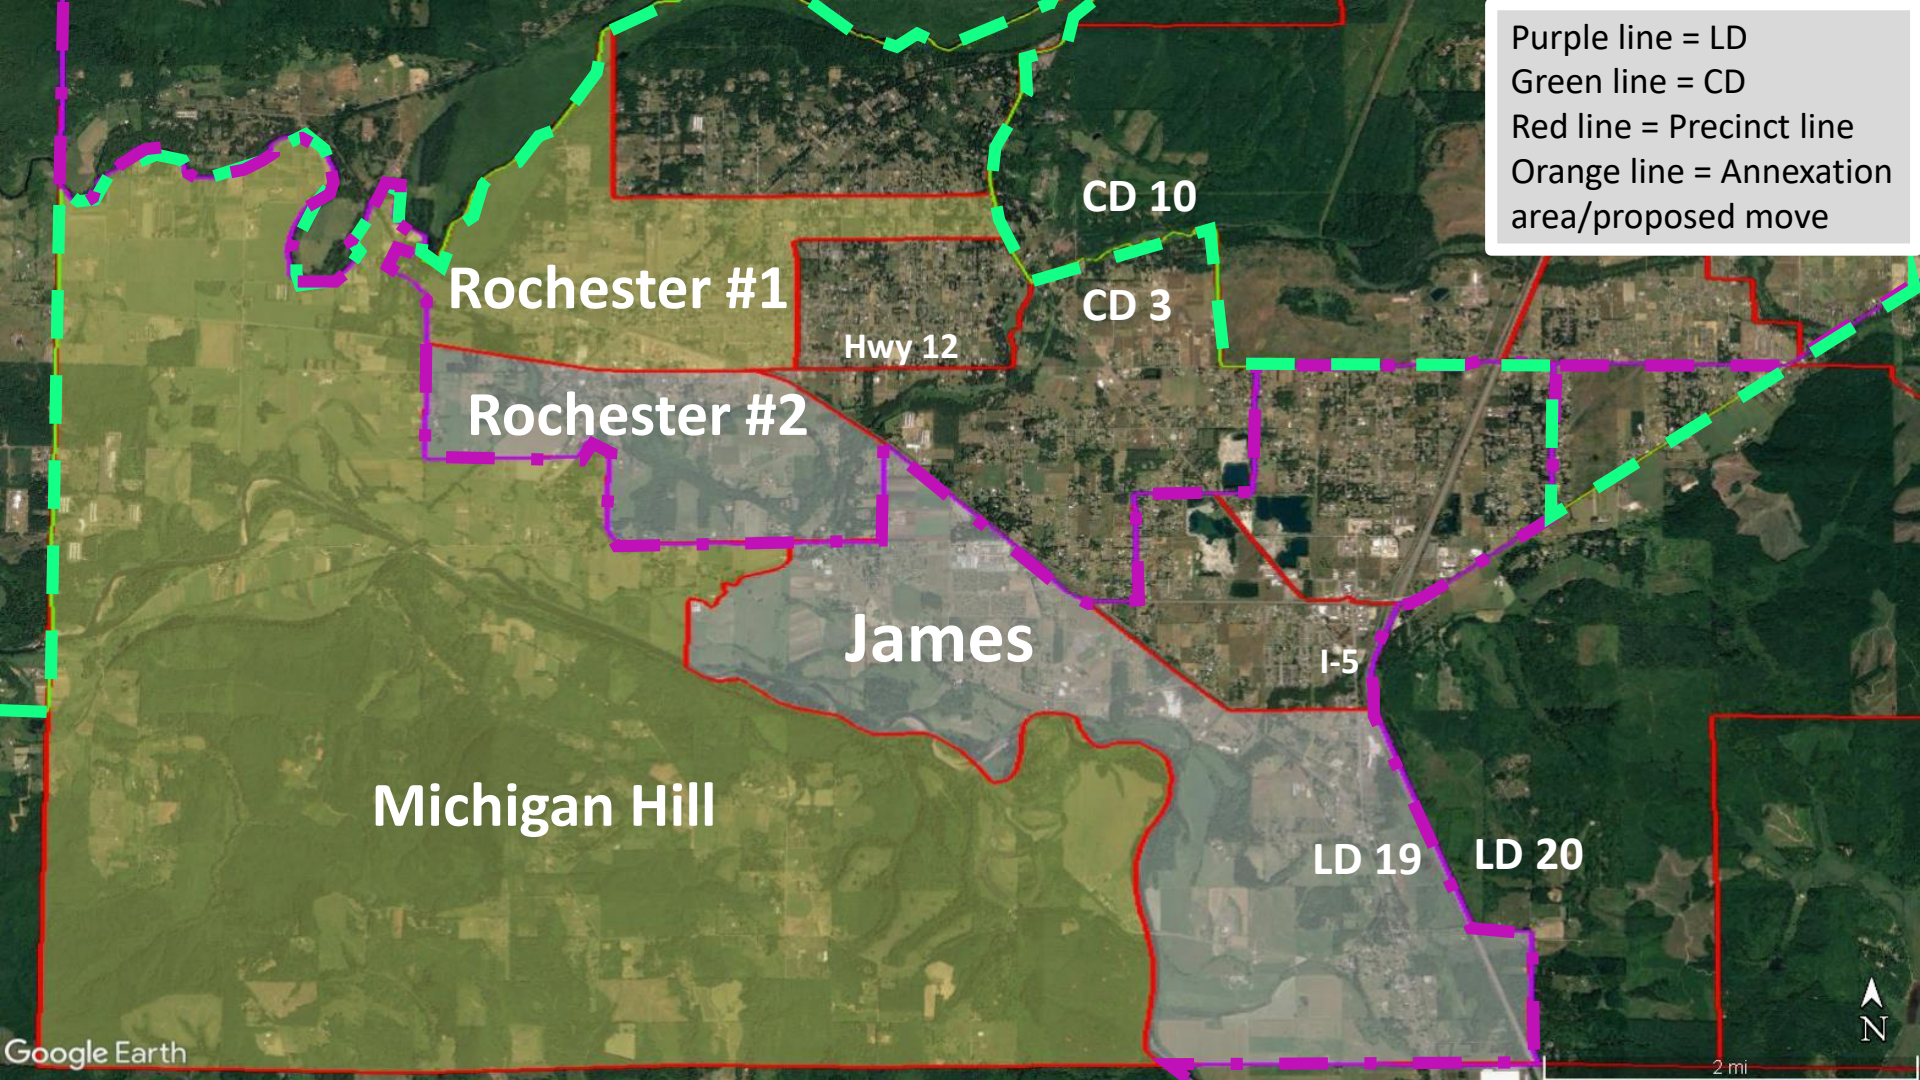


Michigan Hill (Pct. 48), Rochester #1 (Pct. 153), Rochester #2 (Pct. 154), and James (Pct. 52)

- Approx. voters affected = 284
- New voter total of Michigan Hill (Pct. 48) = 677
- New voter total of Rochester #1 (Pct. 153) = 1,045
- New voter total of Rochester #2 (Pct. 154) = 606
- New temporary voter total of James (Pct. 52) = 829

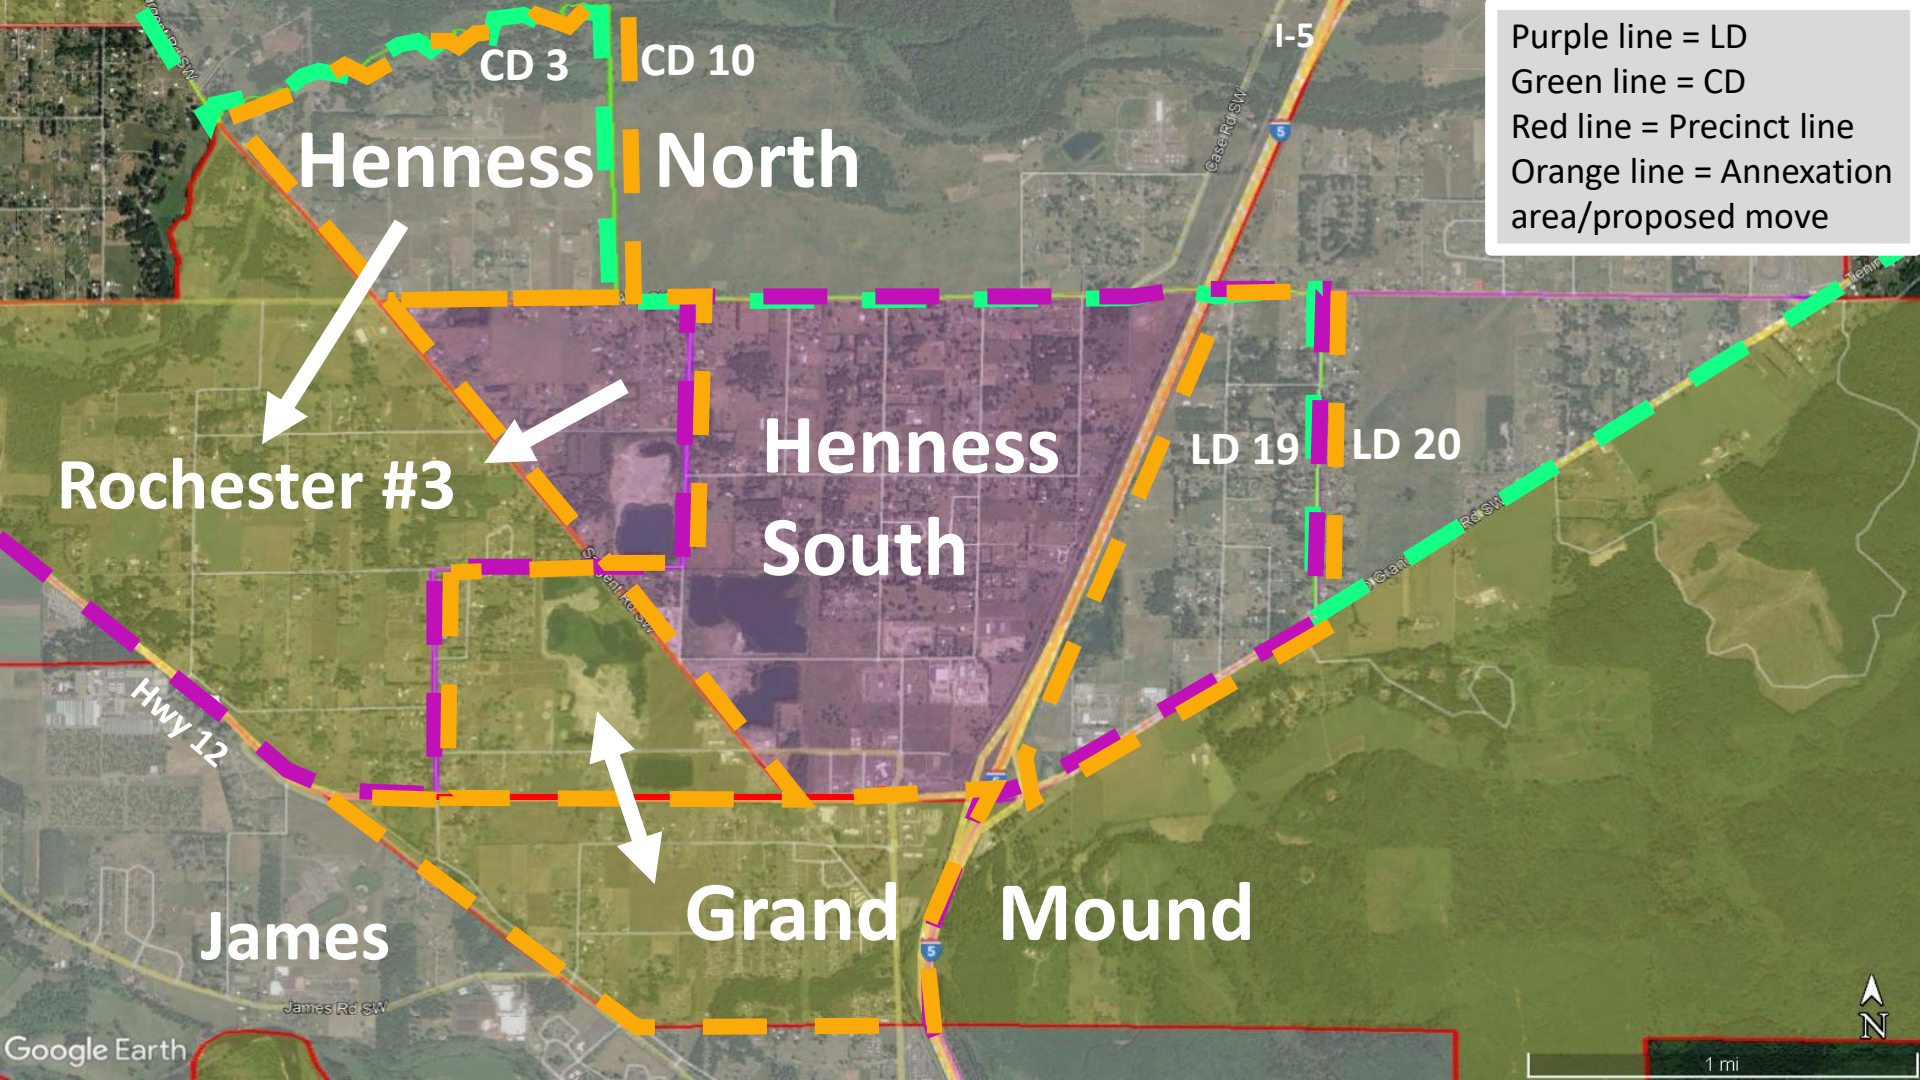


Henness North (Pct. 25), Rochester #3 (Pct. 170), Henness South (Pct. 198), Grand Mound (Pct. 156)

- Approx. voter totals of Henness North = 573, Rochester #3 = 832, Henness South = 823, Grand Mound = 657
- Split Henness North, east/west at CD line, combine south area in CD 3 with Rochester #3
- Split Henness South, east/west at LD line and combine east area with Rochester #3
- Split Rochester #3 and Grand Mound at LD line, merge to create new Grand Mound West (Pct. 20)
- Reform Grand Mound from east area in LD 20, rename as Grand Mound East (Pct. 156)

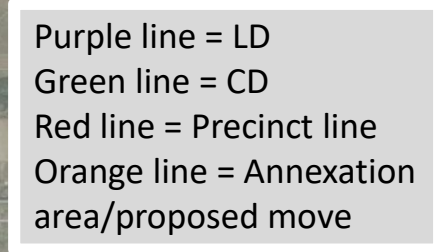


- Approx. voters affected = 1,053
- New voter total for Henness North (Pct. 198) = 446 and Rochester #3 (Pct. 170) = 930
- New temporary voter total for Henness South (Pct. 198) = 640
- New temporary voter total for Grand Mound East (Pct. 156) = 126
- Voter total for new Grand Mound West (Pct. 20) = 743

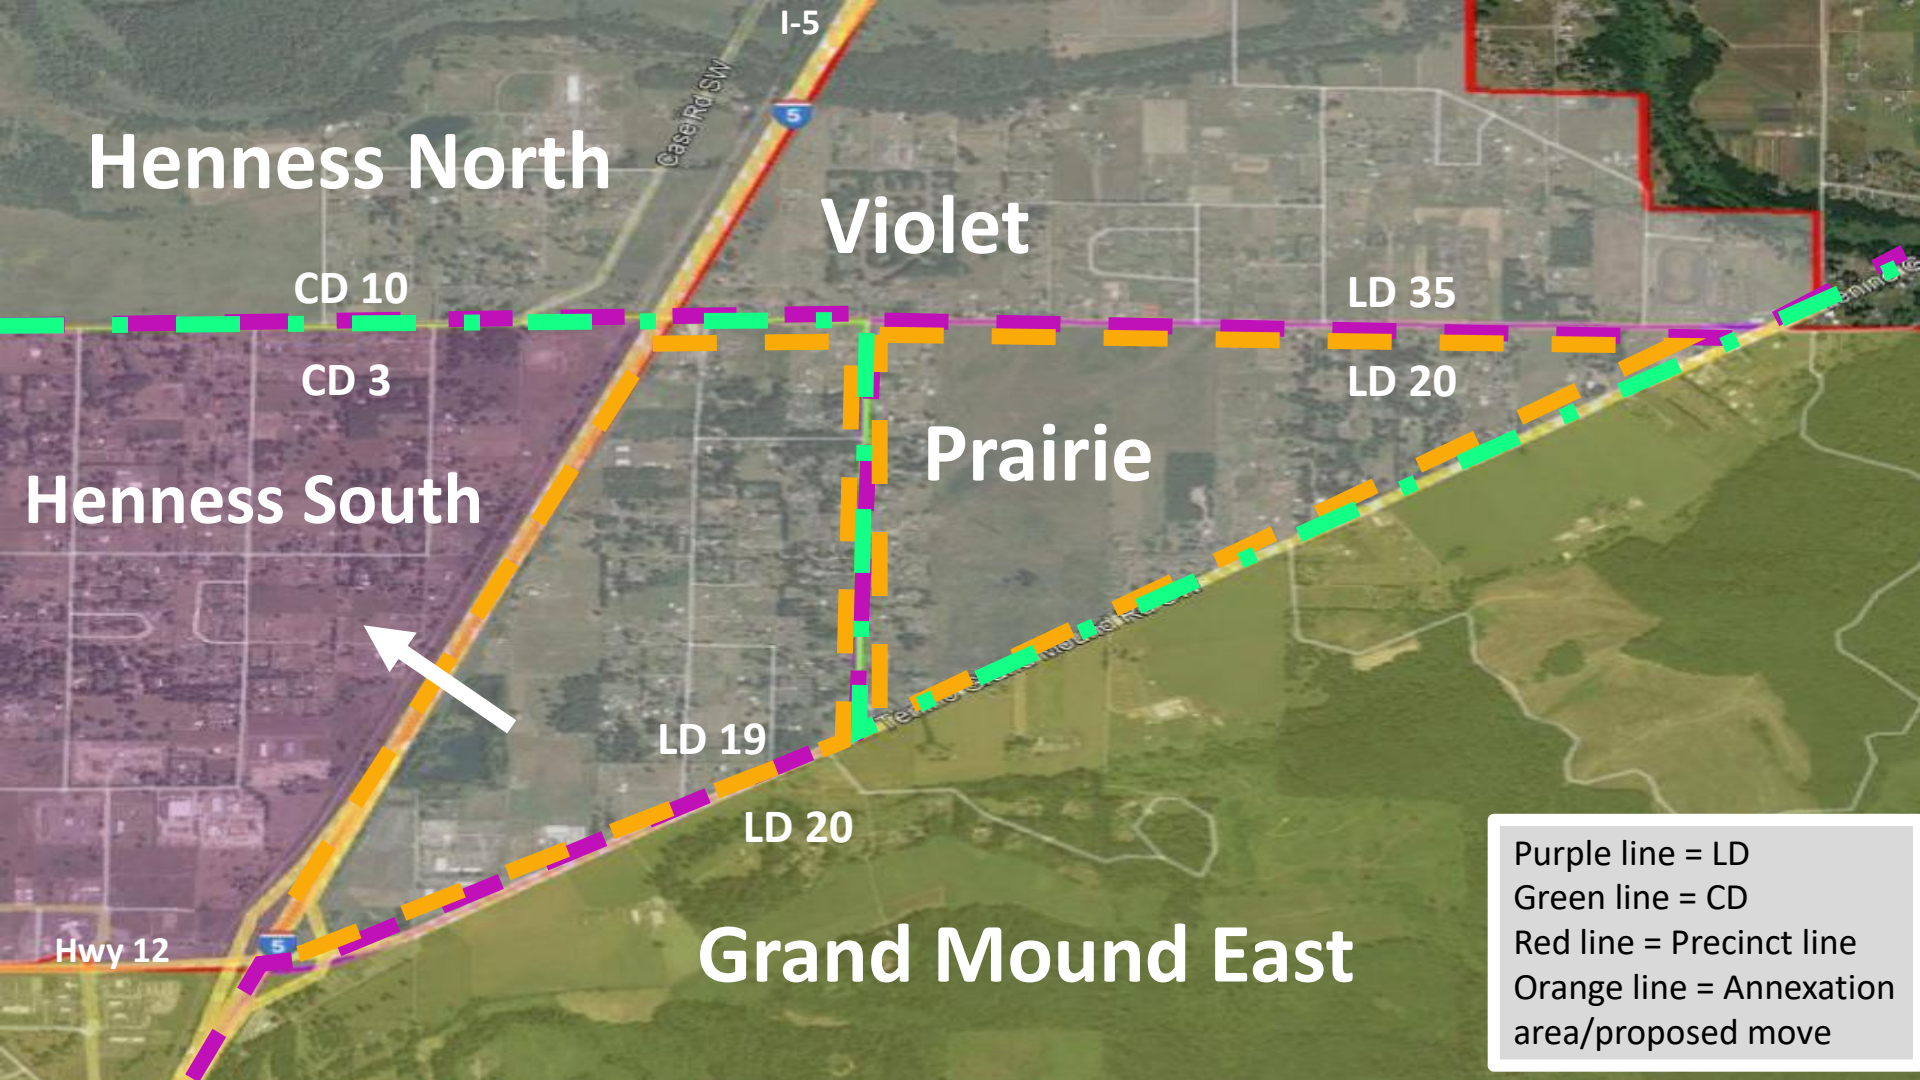


Henness South (Pct. 198) and Violet Prairie (Pct. 150)

- Approx. voter totals for Hennes South = 823 and Violet Prairie = 1,172
- Split Violet Prairie into 3 areas at CD and LD lines
- Area split off by both CD and LD lines to create new Violet Prairie South (Pct. 21)
- Area east, split off only by LD line to combine with Hennes South (Pct. 198)

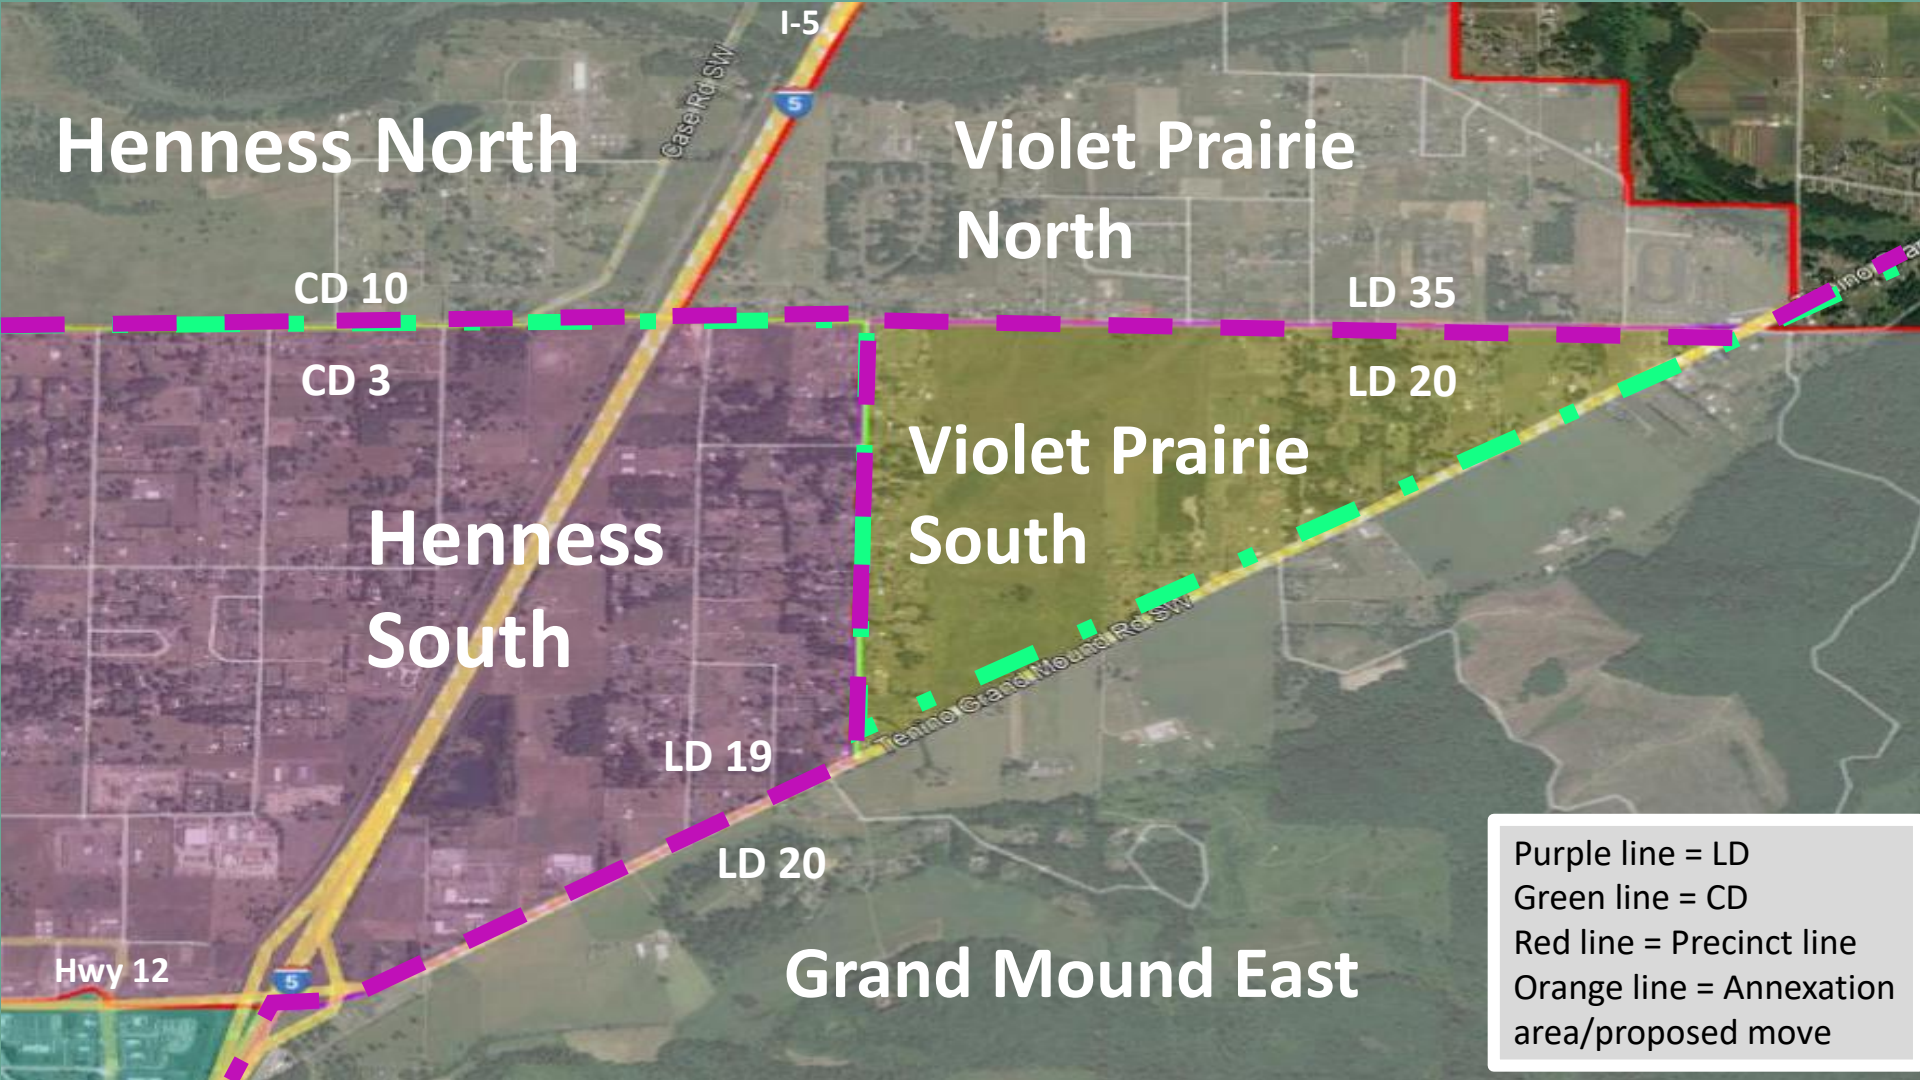


Henness South (Pct. 198) and Violet Prairie (Pct. 150)

- Approx. voters affected = 625
- New (final) voter total for Henness South (Pct. 198) = 966
- New voter total for Violet Prairie North (Pct. 150) = 547
- Voter total for new Violet Prairie South (Pct. 21) = 299

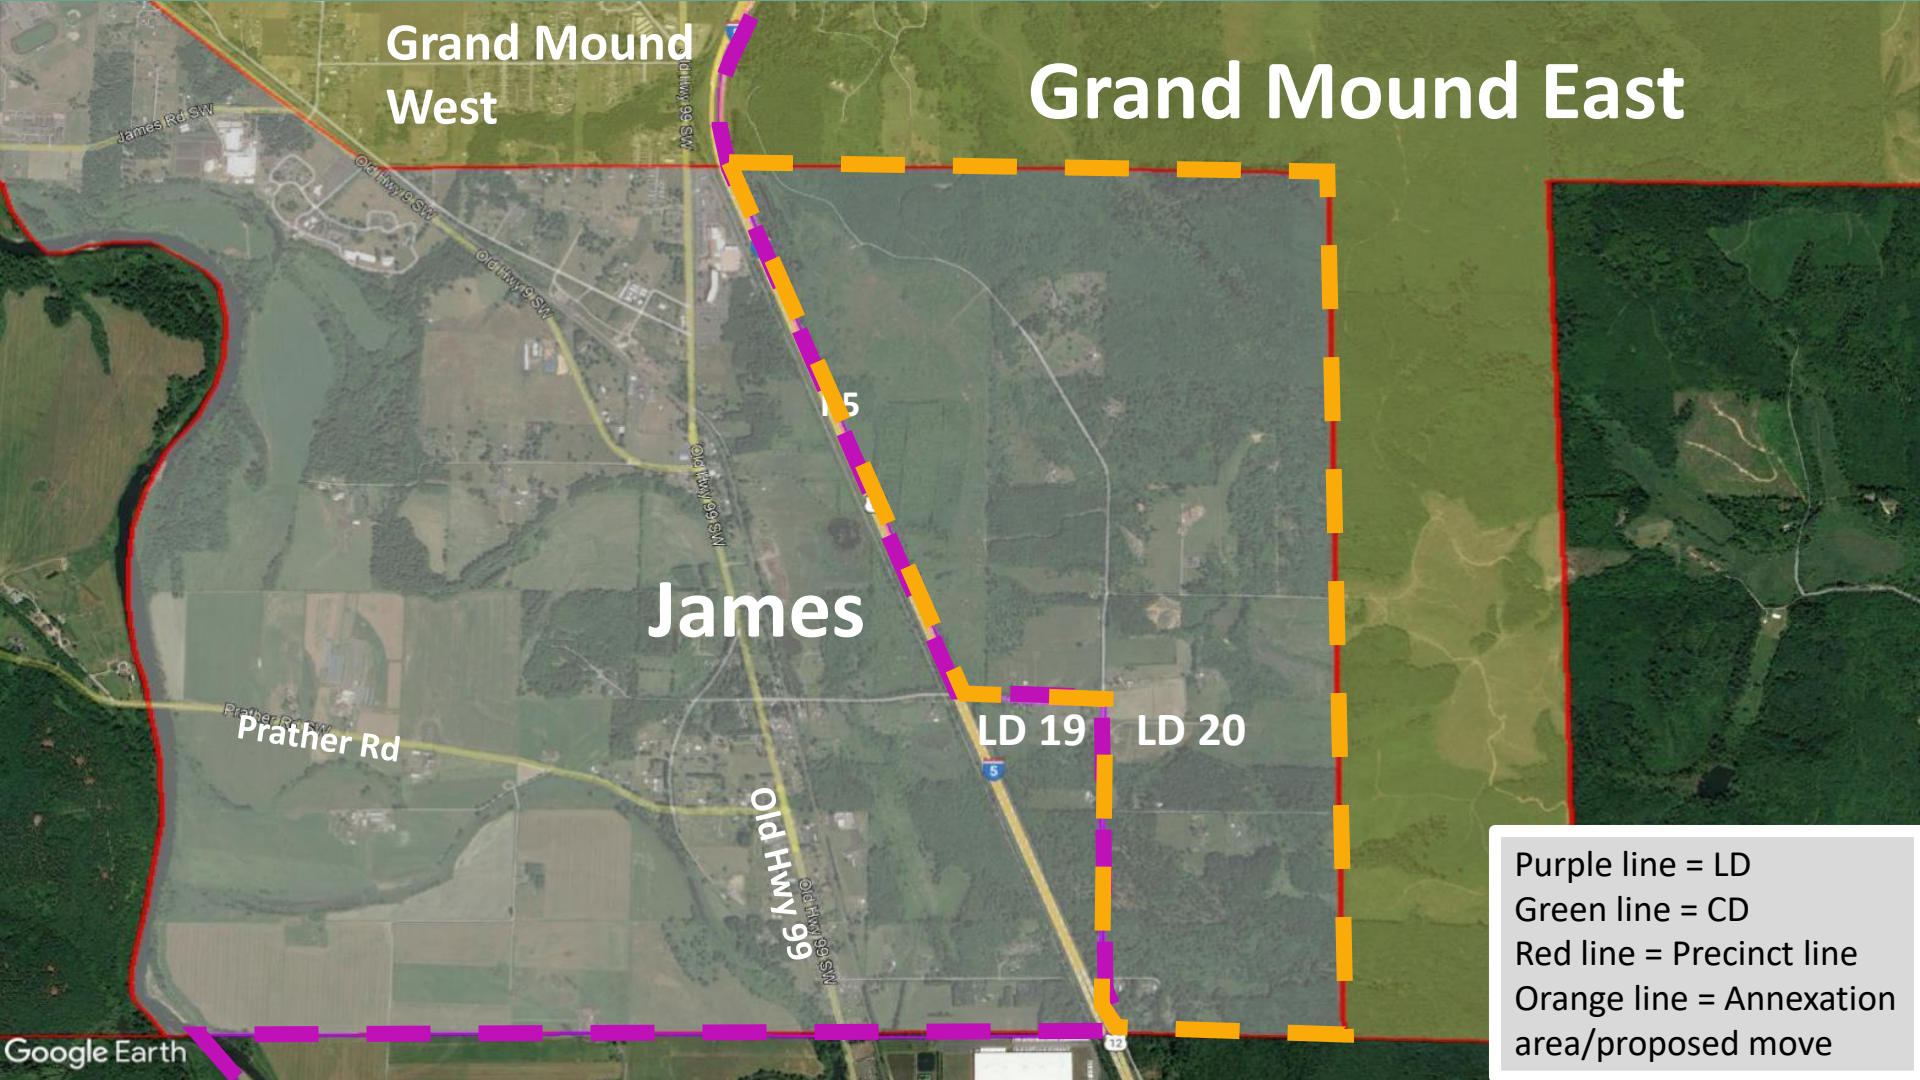


James (Pct. 52) and Grand Mound (Pct. 156)

- Approx. voter total of James = 829
- Approx. voter total of Grand Mound = 657
- Split James (Pct. 52) east and west at LD line
- Combine area in LD 20 with Grand Mound East (Pct. 156)
- Approx. voters affected = 46

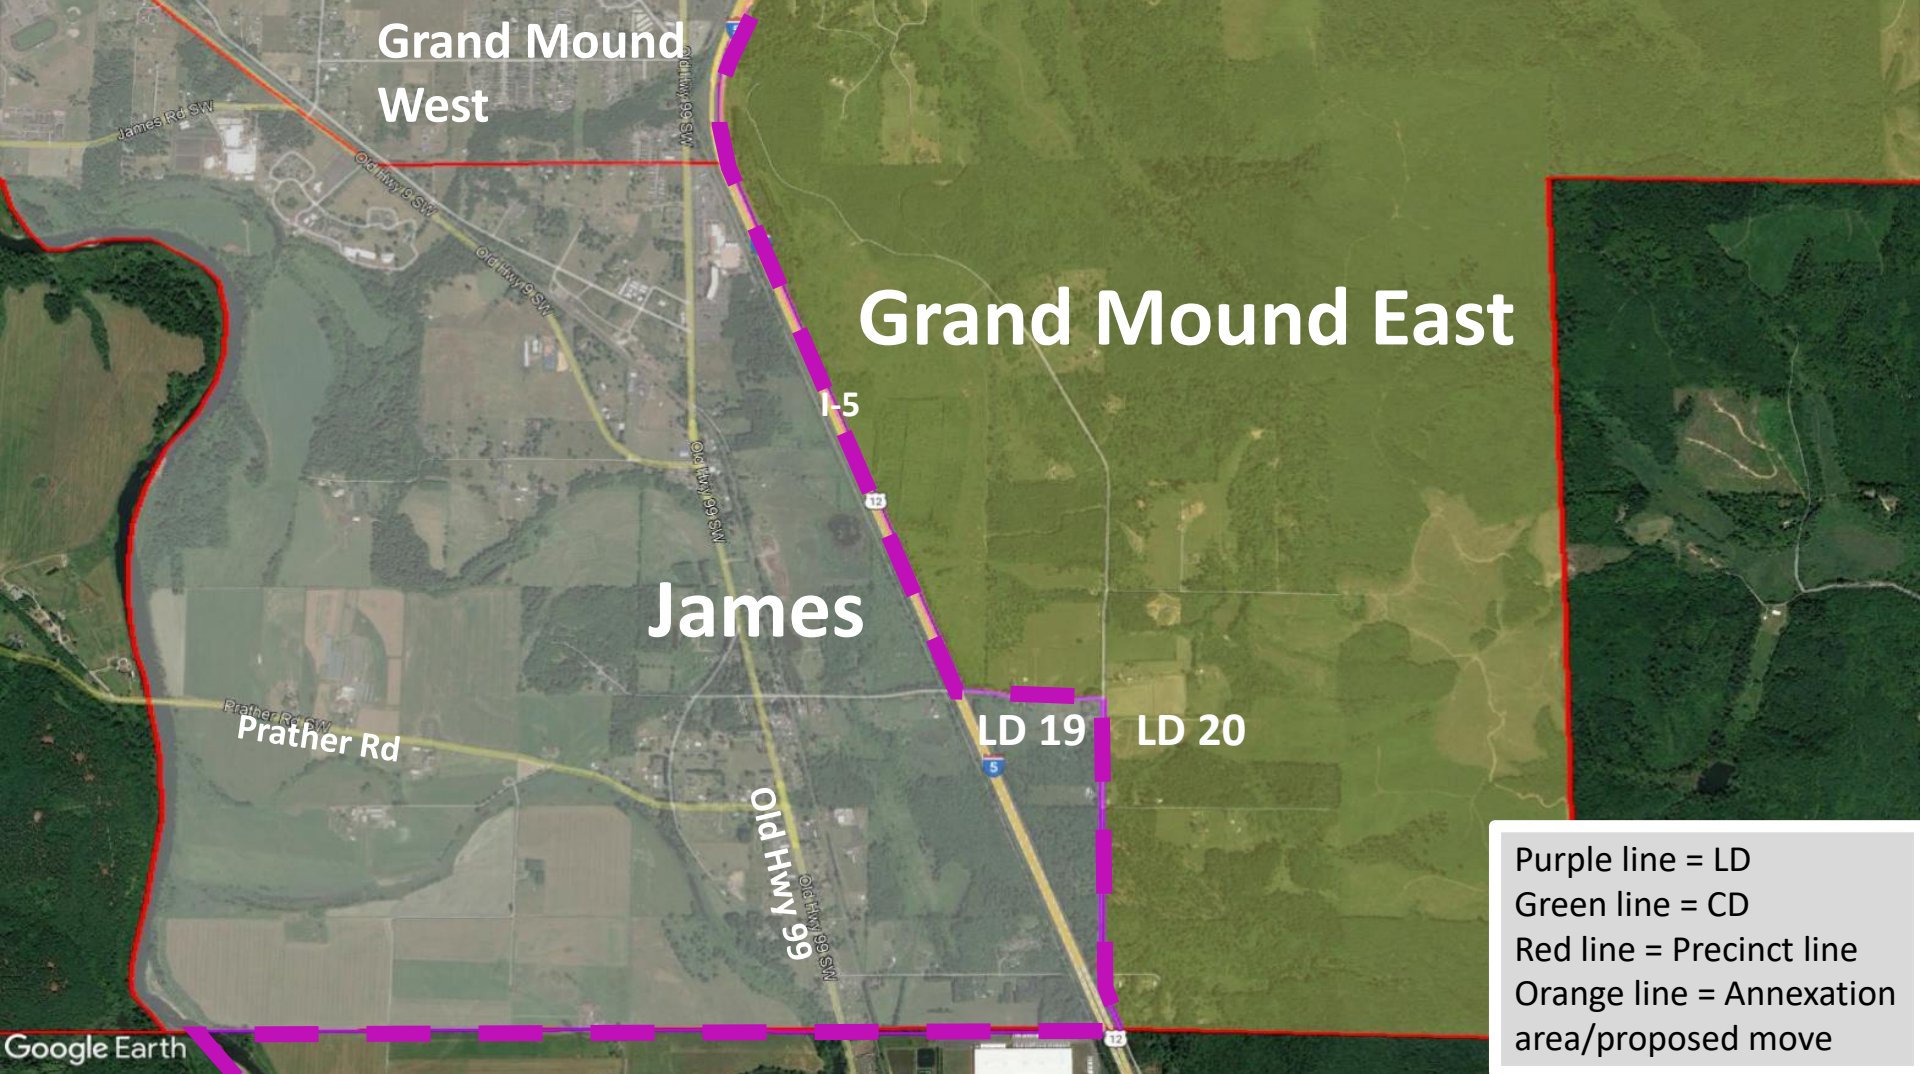


James (Pct. 52) and Grand Mound (Pct. 156)

- New (final) voter total for James (Pct. 52) = 783
- Voter total (Final) for new Grand Mound East (Pct. 156) = 172

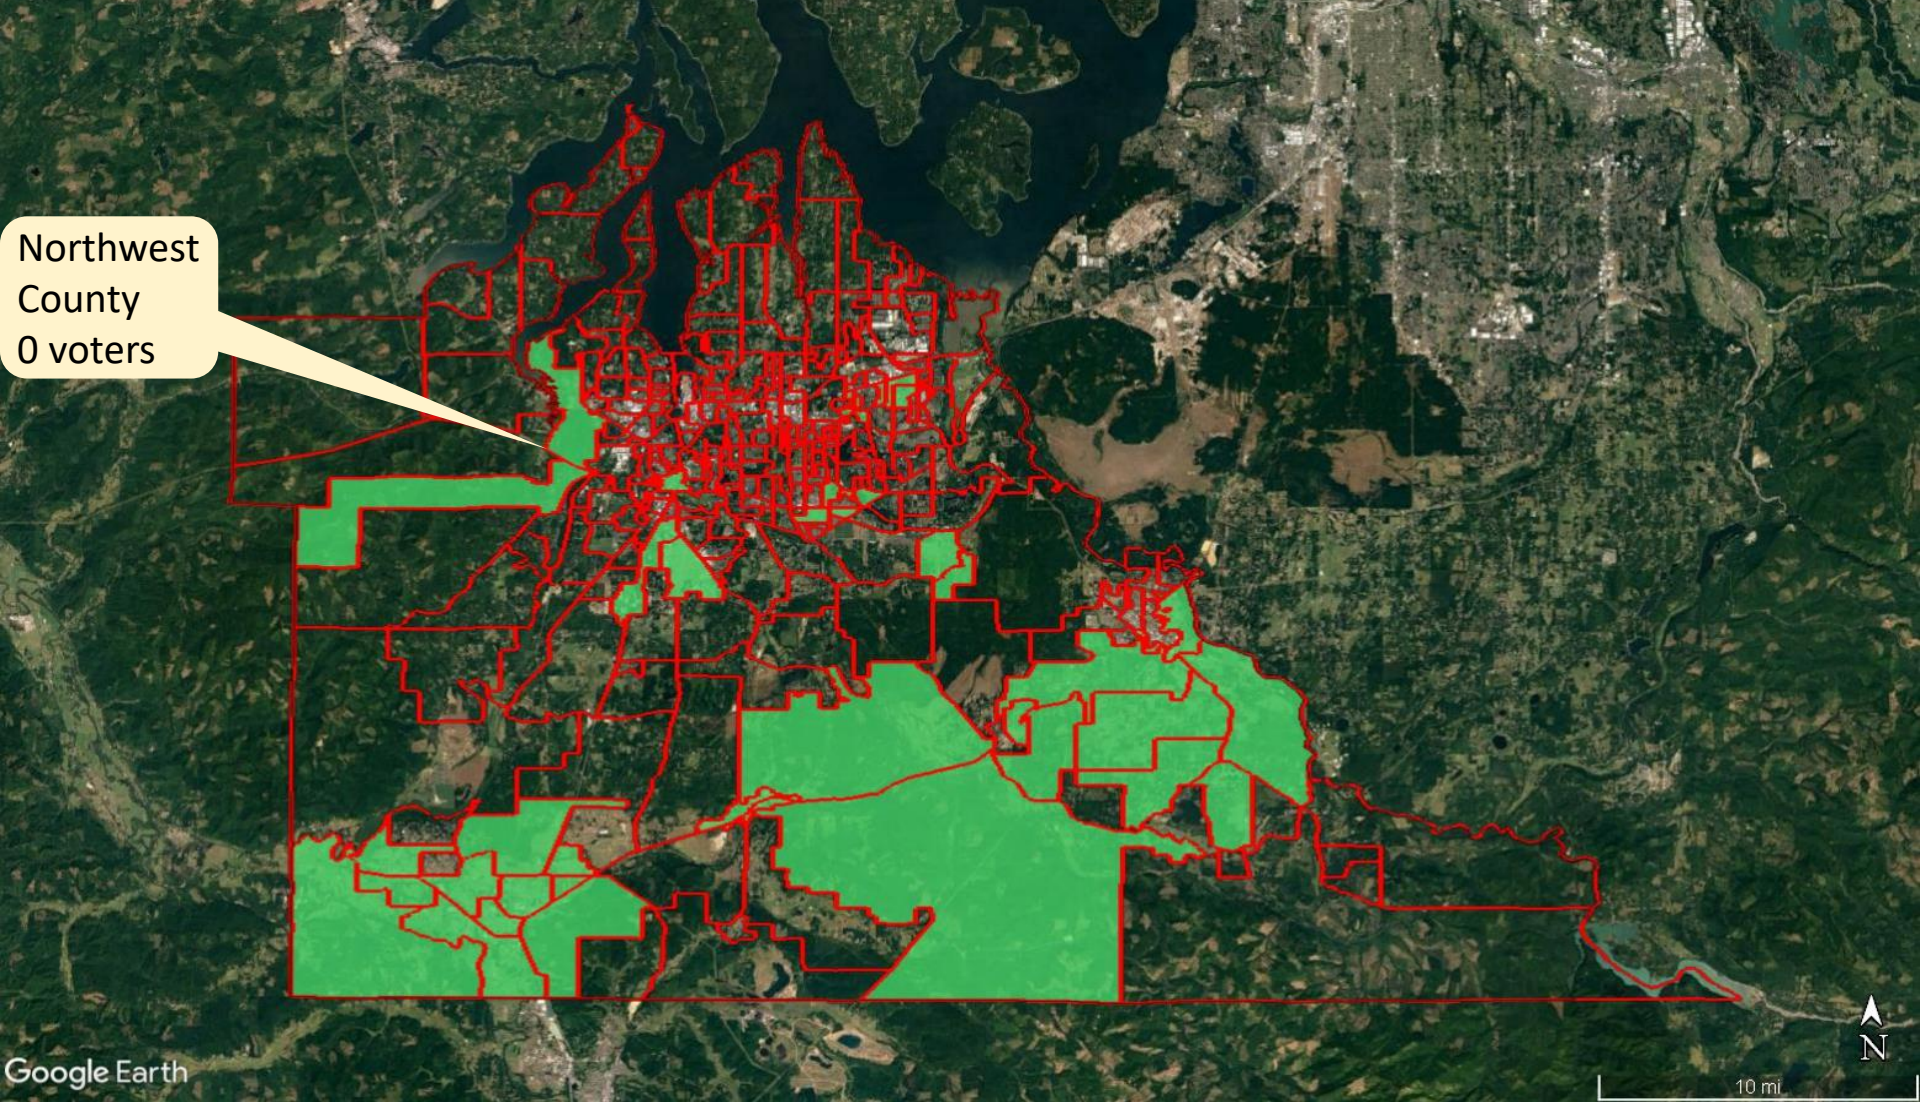

Northwest County


- Legislative District splits one precinct
- Approx. voters affected = 0

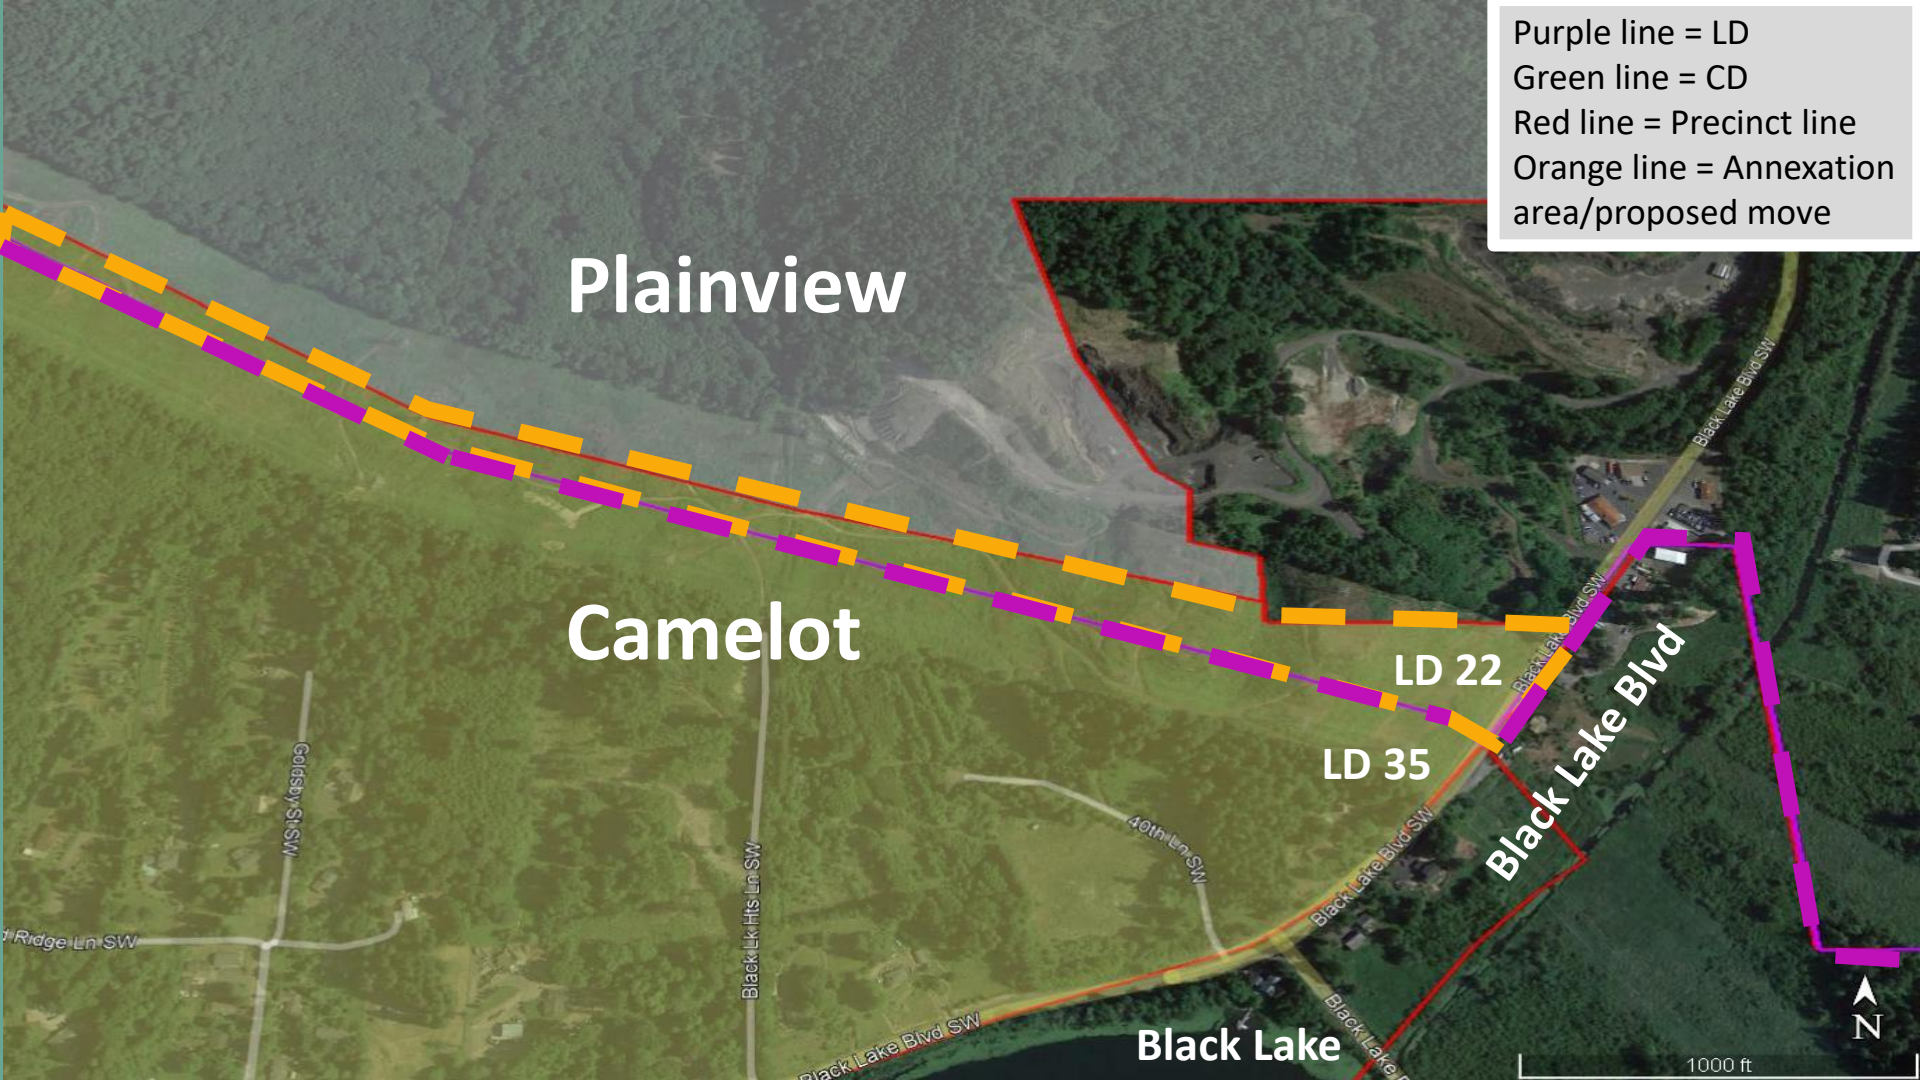

NW County - Plainview (Pct. 139) and Camelot (Pct. 173)


- Approx. voter totals of Plainview = 1,017 and Camelot = 435
- Split Camelot along LD line (LD 22 = north, LD 35 = south)
- Combine Camelot (Pct. 173) in LD 22 with Plainview (Pct. 139)
- Approx. voters affected = 0

Purple line = LD
Green line = CD
Red line = Precinct line
Orange line = Annexation
area/proposed move

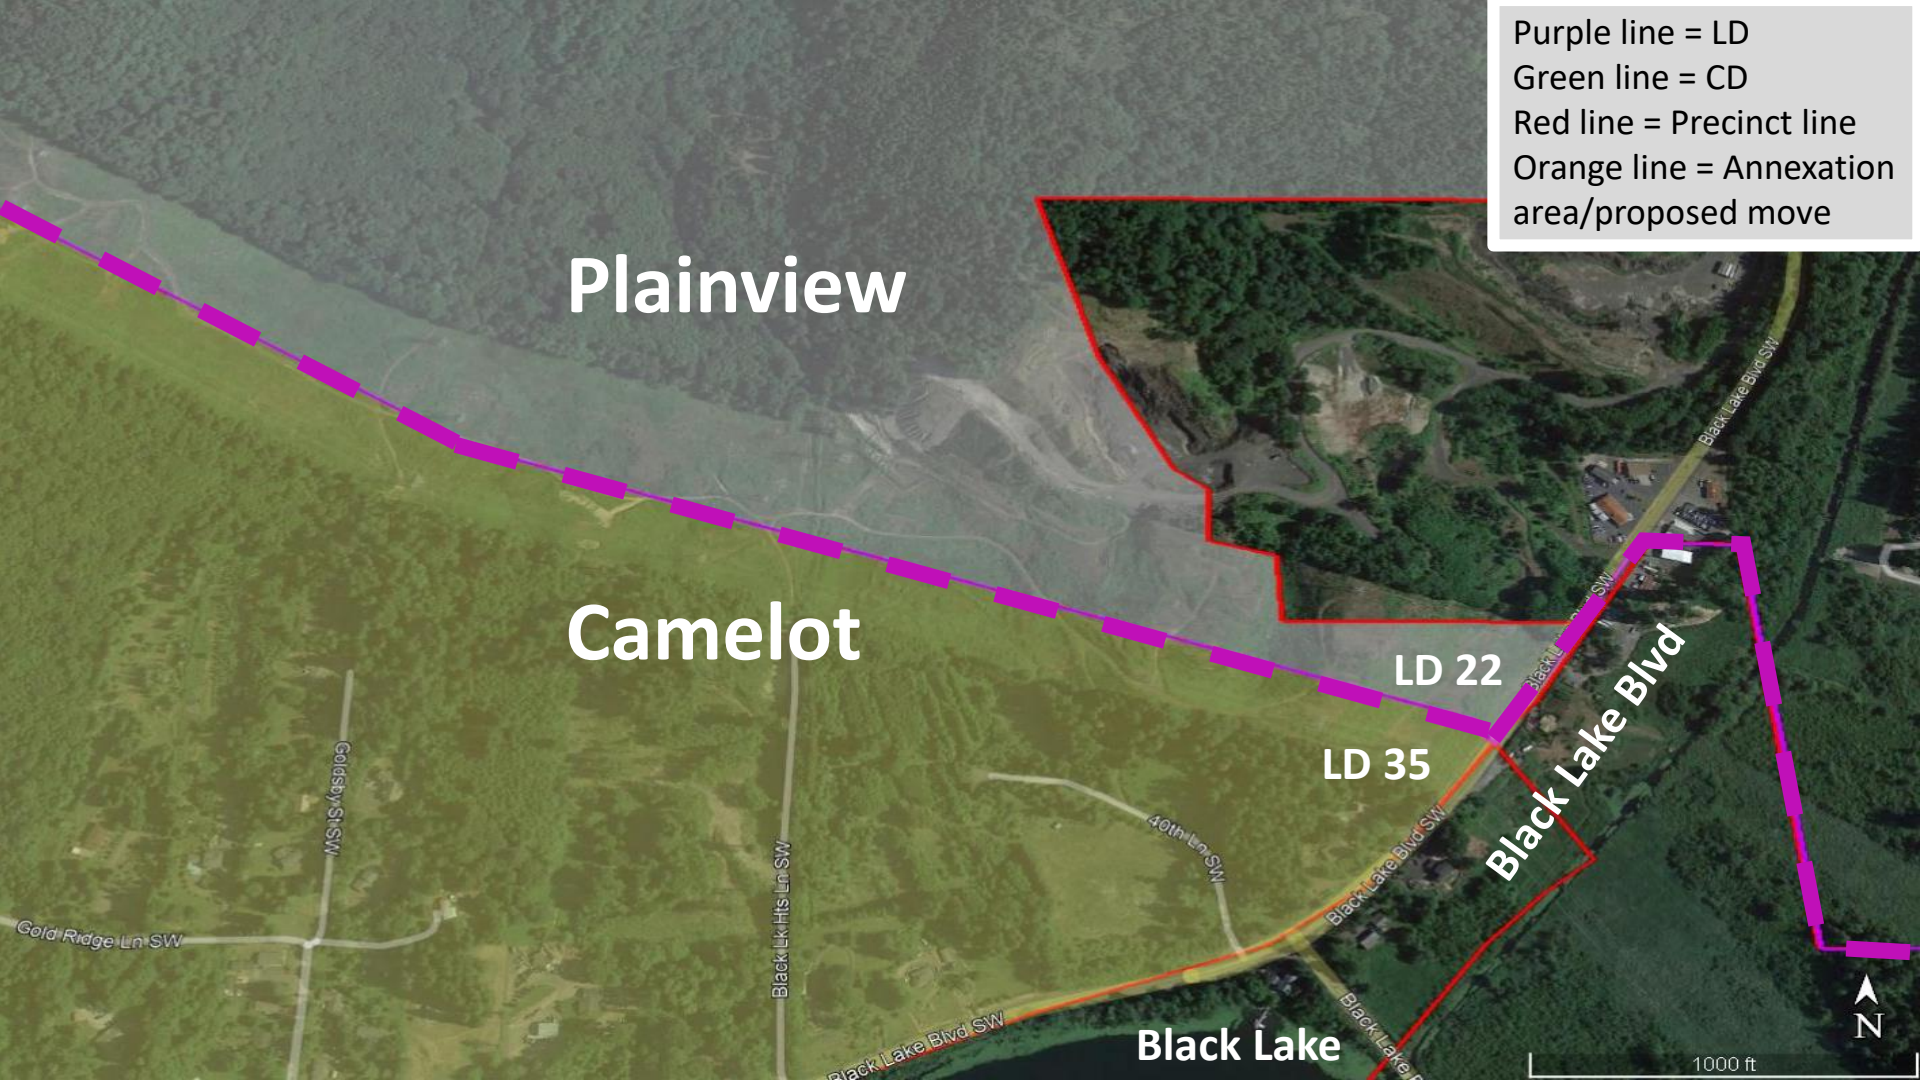


NW County - Plainview (Pct. 139) and Camelot (Pct. 173)

- New voter total for Plainview (Pct. 139) = 1,017
- New voter total for Camelot (Pct. 173) = 435

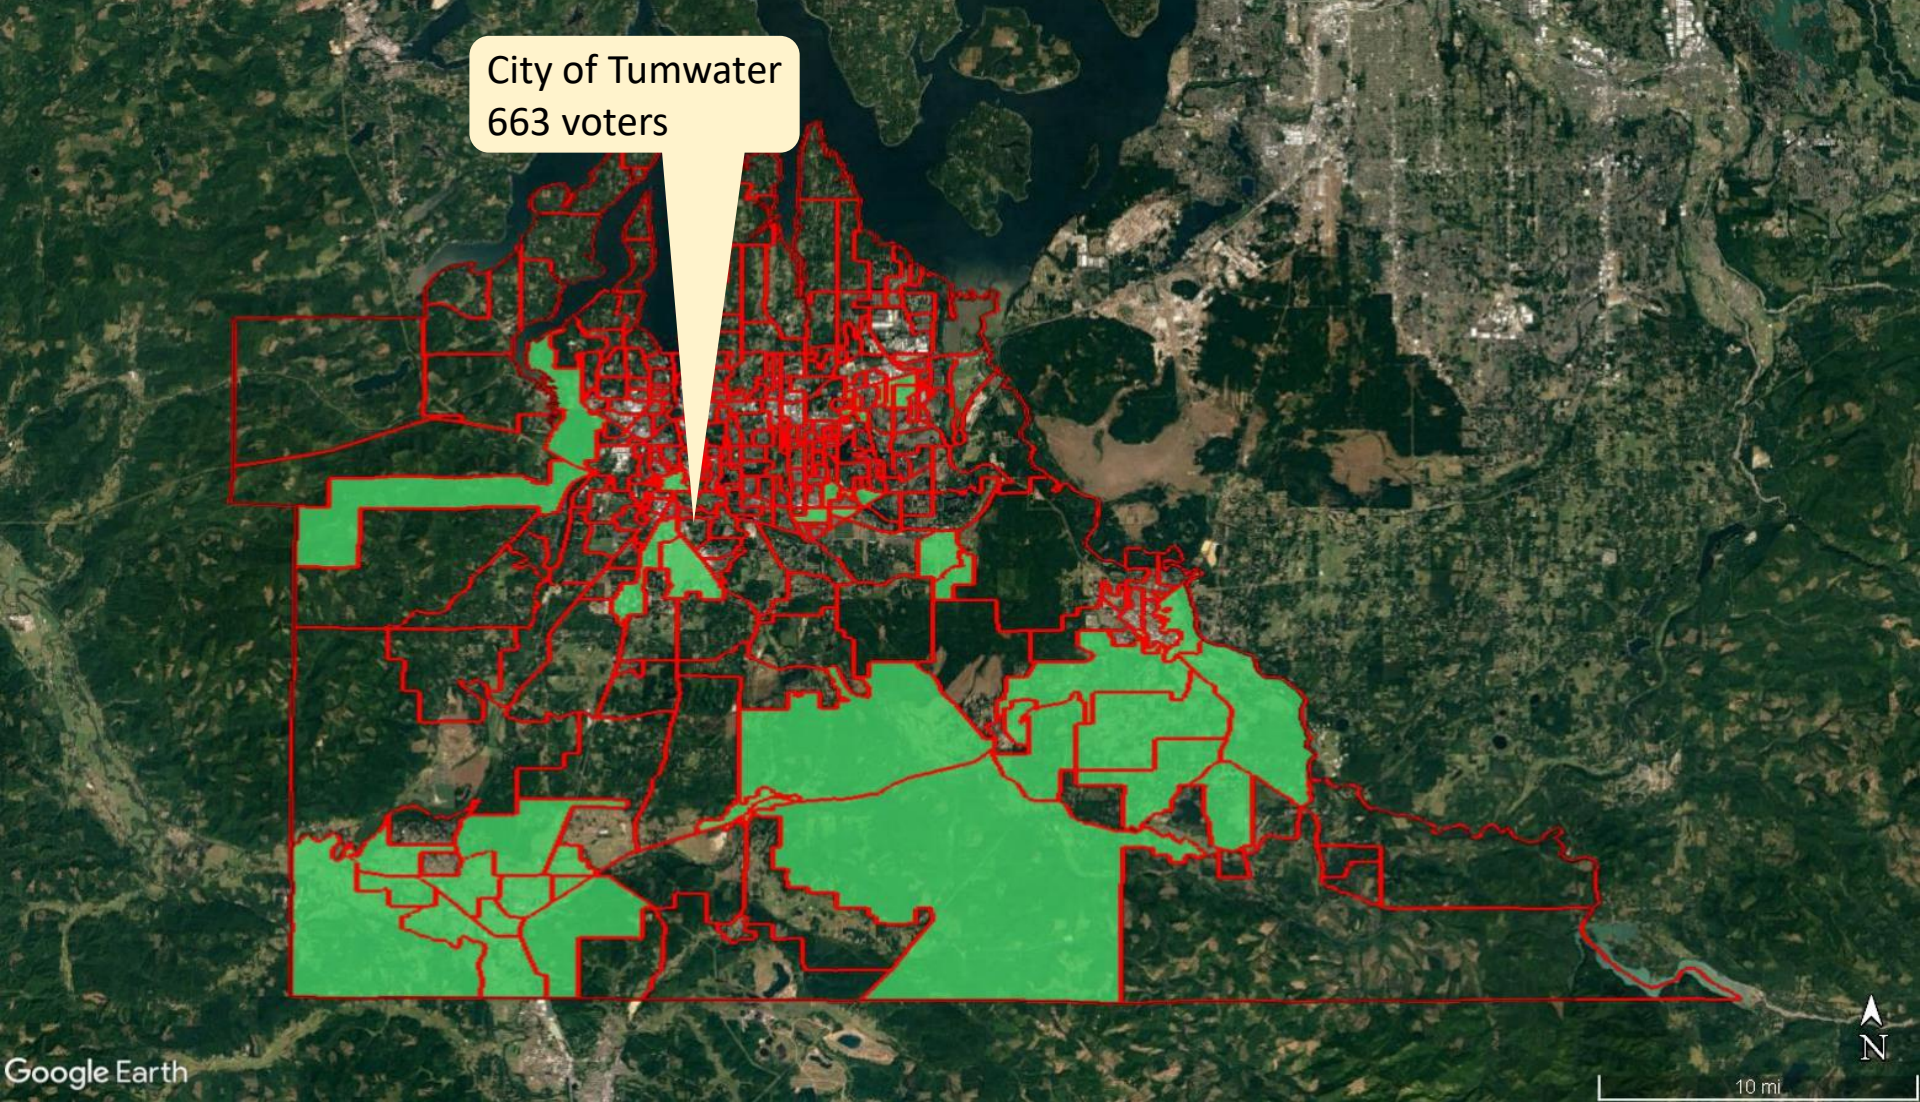


City of Tumwater

- One precinct over 1,500 active registered voters
- One city boundary adjustment
- Approx. voters affected = 663

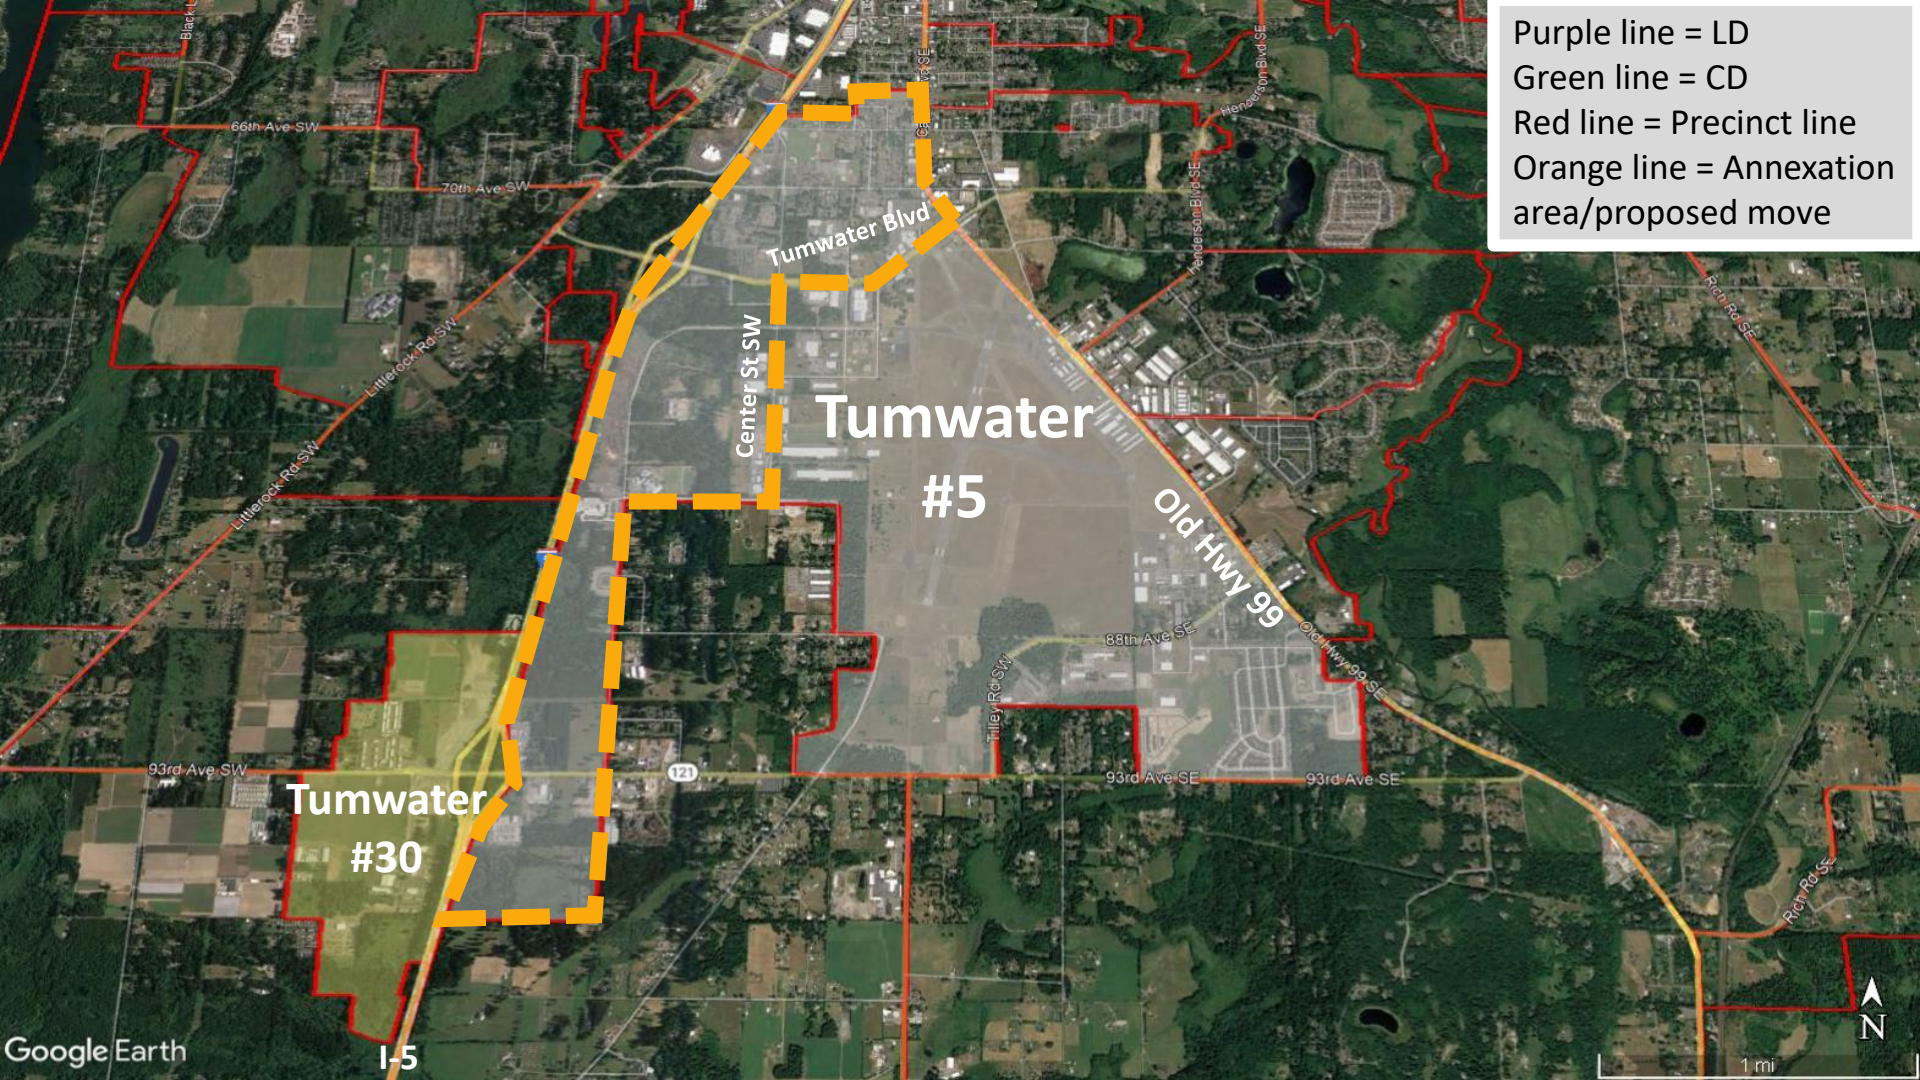

City of Tumwater - Tumwater #5 (Pct. 405) and Tumwater #30 (Pct. 430)

- Approx. voter totals of Tumwater #5 = 1,515 and Tumwater #30 = 5
- Split Tumwater #5 in half from the east along Tumwater Blvd to Center St
- Reform Tumwater #5 (Pct. 405) from area southeast of split
- Combine area west with Tumwater #30 (Pct. 430)
- Approx. voters affected = 661

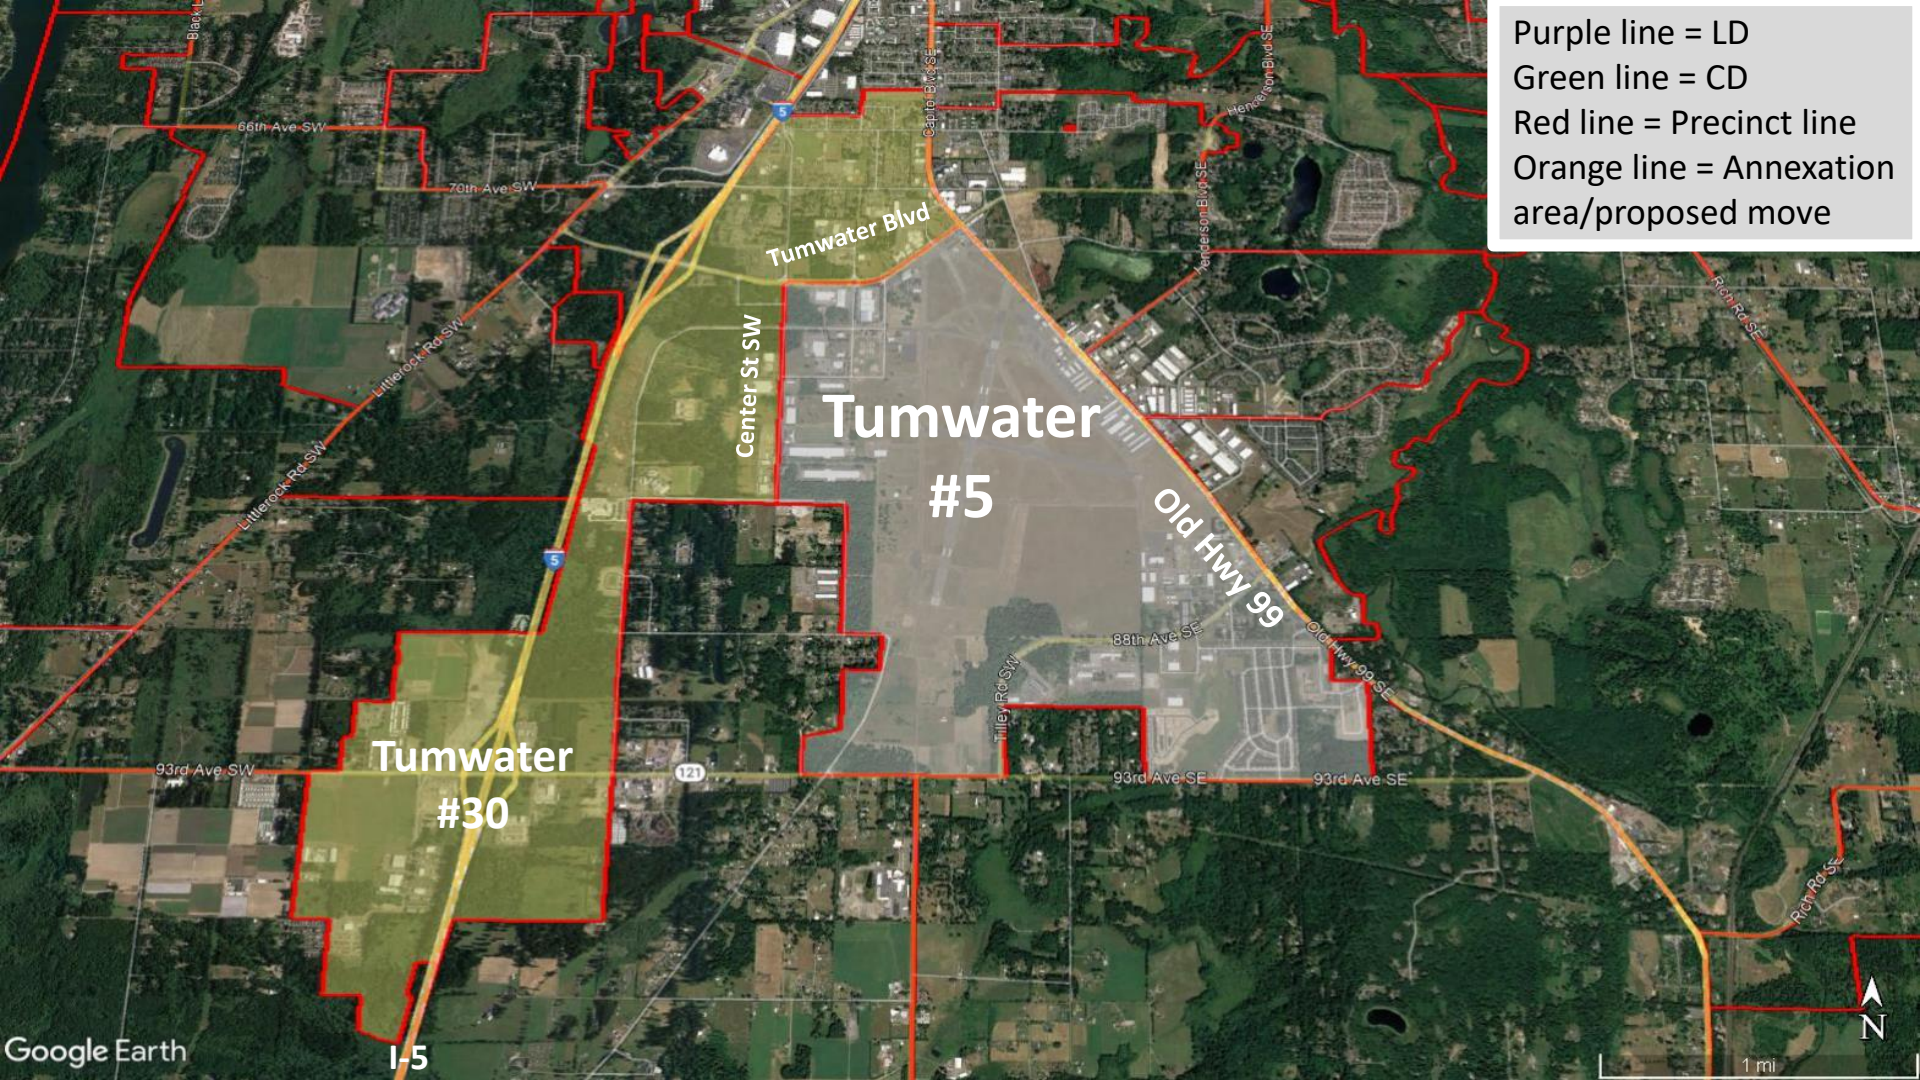

City of Tumwater - Tumwater #5 (Pct. 405) and Tumwater #30 (Pct. 430)

- New voter total for Tumwater #5 (Pct. 405) = 854
- New voter total for Tumwater #30 (Pct. 430) = 666



City of Tumwater - Tumwater #3 (Pct. 403) and Simmons #4 (Pct. 70)

- City of Tumwater boundary update
- Approx. voter totals for Tumwater #3 = 905 and Simmons #4 = 39
- Move parcel from Simmons #4 into Tumwater #3
- Approx. voters affected = 2



Purple line = LD
Green line = CD
Red line = Precinct line
Orange line = Annexation area/proposed move

Simmons
#4*

Tumwater #3

City of Tumwater - Tumwater #3 (Pct. 403) and Simmons #4 (Pct. 70)

- New voter total for Tumwater #3 (Pct. 403) = 907
- New voter total for Simmons #4 (Pct. 70) = 37



Proposed Results

- **Proposed 2022 Precinct Count** = 292
- **Approximate Voters Affected** = 7,239 (3.71%)
- **Voting Precincts Added** = 9 (Four Corners South, Grand Mound West, Violet Prairie South, Eaton Creek North, Pattison East, Kinwood East, Lacey #56, Lacey #57, Lacey #58)
- **Legal Descriptions Added** = 9 (Four Corners South, Grand Mound West, Violet Prairie South, Eaton Creek North, Pattison East, Kinwood East, Lacey #56, Lacey #57, Lacey #58)
- **Voting Precincts Repealed** = 2 (Freedom, Hawks Ridge)
- **Legal Descriptions Repealed** = 2 (Freedom, Hawks Ridge)
- **Voting Precinct Names Changed** = 6 (Four Corners to Four Corners North, Grand Mound to Grand Mound East, Violet Prairie to Violet Prairie North, Eaton Creek to Eaton Creek South, Pattison to Pattison West, Kinwood to Kinwood West)



Proposed Results Continued...

- **Precinct Boundary Adjustments** = 37 (Heness North, Morris, Michigan Hill, James, Vail, Smith Prairie, Simmons #4, Mushroom Corner, Trailblazer, Kinwood, Fleetwood, Lydia Hawk, Deschutes, Longmire, Weir Prairie, Plainview, McIntosh, Violet Prairie, Rochester #1, Rochester #2, Grand Mound, Eaton Creek, Rochester #3, Camelot, Pattison, Four Corners, Meadows, Henness South, Lacey #27, Lacey #32, Lacey #42, Tumwater #3, Tumwater #5, Tumwater #30, Tenino #1, Tenino #2, Rainier #1)
- **Precinct Legal Descriptions Amended** = 34 (Heness North, Morris, Michigan Hill, James, Vail, Smith Prairie, Mushroom Corner, Trailblazer, Kinwood, Fleetwood, Lydia Hawk, Deschutes, Longmire, Weir Prairie, Plainview, Violet Prairie, Rochester #1, Rochester #2, Grand Mound, Eaton Creek, Rochester #3, Camelot, Pattison, Four Corners, Meadows, Henness South, Lacey #22, Lacey #27, Lacey #32, Lacey #42, Lacey #49, Tumwater #5, Tumwater #30, Rainier #1)



Proposed Results Continued...

- **Commissioner Legal Descriptions Amended** = 3 (amend Commissioner District No. 1 to reflect 3 added precincts and 1 repealed precinct, amend Commissioner District No. 2 to reflect 4 added precincts and 1 repealed precinct, and amend Commissioner District No. 3 to reflect 2 added precincts.) **No boundary changes. No voter total changes.**



Thank You